

Interim Seismic Retrofit-East Bay 288' Trusses Yerba Buena Island (Contract No. 04-043004)

The as-built drawings, which are contained in these CDs, are scanned from drawings of the existing structure for the convenience of the contractor and as a means to convey to the contractor the available information regarding the existing structure. It is to be understood that no claim is being made as to the accuracy or completeness of the said information and that the State of California or its officers or agents shall not be responsible for the manner in which the contractor interprets and uses this information or for the accuracy, currency or completeness of these scanned as-built drawings. The contractor shall be responsible to obtain, at the contractor’s expense, any additional information that the contractor deems necessary for completely and accurately assessing the existing conditions of the structure. The contractor shall not be entitled to any compensation for any claim arising from inaccuracy or insufficiency of these as-built drawings or in anyway related to these drawings.

- [69. General Plan](#)
- [70. Index to Plans](#)
- [71. Structural Layout No. 1](#)
- [72. Structural Layout No. 2](#)
- [73. Pier YB-2](#)
- [74. Pier YB-4](#)
- [75. Tower Member ‘CS6’ and ‘CS7’](#)
- [76. Tower Member ‘CS10’ thru ‘CS15’](#)
- [77. Tower Member ‘CS24’ and ‘CS25’](#)
- [78. Tower Member ‘CS31’ and ‘CS32’](#)
- [79. Pier YB-3 No. 1](#)
- [80. Pier YB-3 No. 2](#)
- [81. Pier YB-3 No. 3](#)
- [82. Lower Chord L15-L17](#)
- [83. Lower Chord L15A-L17A](#)
- [84. Lower Chord L18-L20](#)
- [85. Lower Chord L18A-L20A](#)
- [86. Base Plate Details](#)
- [87. Tie Rod Assembly Unit Details](#)
- [88. Vertical Member Retrofit Miscellaneous Notes](#)
- [89. Vertical Member Detail No. 1 \(North\)](#)
- [90. Vertical Member Detail No. 2 \(North\)](#)
- [91. Vertical Member Detail No. 3 \(North\)](#)
- [92. Vertical Member Detail No. 4 \(South\)](#)
- [93. Vertical Member Detail No. 5 \(South\)](#)
- [94. Vertical Member Detail No. 6 \(South\)](#)
- [95. Miscellaneous Details No. 1](#)
- [96. Miscellaneous Details No. 2](#)
- [97. Miscellaneous Details No. 3](#)
- [98. Miscellaneous Details No. 4](#)
- [99. Barrier Details No. 1](#)
- [100. Barrier Details No. 2](#)
- [101.Barrier Details No. 3](#)
- [102.Barrier Details No. 4](#)
- [103.Pier #1 Anchorage Details No. 1](#)
- [104.Pier #1 Anchorage Details No. 2](#)

Donald Lee
REGISTERED ENGINEER - CIVIL
October 21, 1997
12-8-97
PLANS APPROVAL DATE

RECEIVED PROFESSIONAL ENGINEER
DER-FU DONALD LEE
No. 50978
Exp. 9-30-01
CIVIL
STATE OF CALIFORNIA

Indicates Existing Structures

Indicates New Construction

1	Tower Member Retrofit
2	Lower Chord Retrofit
3	Add Vertical Bracing Member
4	Tower Connection Retrofit
5	Vertical Member Retrofit
6	Truss Support Retrofit

WORK AREA MONITORING	LUMP SUM
BRIDGE REMOVAL (PORTION), LOCATION B	LUMP SUM
STRUCTURAL CONCRETE, BRIDGE	3 CY
DRILL AND BOND DOWEL	41 LF
BAR REINFORCING STEEL (BRIDGE)	1,490 LB
FURNISH STRUCTURAL STEEL (BRIDGE)	269,800 LB
ERECT STRUCTURAL STEEL (BRIDGE)	269,800 LB
CLEAN AND PAINT STRUCTURAL STEEL	LUMP SUM
SPOT BLAST CLEAN AND PAINT UNDERCOAT	4770 SQFT



1 - 150-0

SAN FRANCISCO BAY

Shore Line

Yerba Buena Island

To Oakland

— 678 —

---+---

19

SAN FRANCISCO BAY

PLAN

$N = 150-0^{\circ}$

Q Rte 80 Curve Data

R = 1500.0' ±
Δ = 27° 30' 48"
T = 367.232' ±
L = 720.297' ±

NOTE:
THE CONTRACTOR SHALL VERIFY ALL
CONTROLLING FIELD DIMENSIONS
BEFORE ORDERING OR FABRICATING
ANY MATERIAL.

NOTE:
For 'General Notes' see "Index to Plans" sheet.



No Scale



No Scale

INTERIM SEISMIC RETROFIT PRO

EAST BAY 288 TRUSSES YERBA BUENA

GENERAL PLAN

DESIGN	BY Don Lee	CHECKED E. A. Morris	LOAD FACTOR DESIGN			STATE OF CALIFORNIA DIVISION OF STRUCTURES STRUCTURE DESIGN DEPARTMENT OF TRANSPORTATION TOLL BRIDGES SPECIAL ANALYSIS
DETAILS	BY Janie Chubana	CHECKED E. A. Morris	LAYOUT	BY Don Lee	CHECKED E. A. Morris	
QUANTITIES	BY E. A. Morris	CHECKED Don Lee	SPECIFICATIONS	BY	PLANS AND SPECS COMPARED	

BRIDGE NO.
33-0025
POST MILE
1.5

SAN FRANCISCO-OAKLAND BAY BRIDGE
GENERAL PLAN

ORIGINAL SCALE IN INCHES
FOR REDUCED PLANS

CU 04
EA 04300

DISREGARD PRINTS BEARING
EARLIER REVISION DATES

REVISION DATES (PRELIMINARY STAGE ONLY)						
4-8-97	5-15-97	5-22-97	6-9-97	6-22-97	10-2-97	10-23-97

SHEET	OF
1	36


```
USERNAME => tr1encrd
             b09p001qp!_09|0|648
```

DS 050 2130 (GAD) 10/93

1000

GENERAL NOTES

1. All new connection bolts shall be high strength bolts and shall conform to ASTM A325 bearing type unless otherwise noted in the plans. All high strength bolts in standard size holes shall be furnished with one washer beneath the turning element. All high strength bolts in oversized holes shall be furnished with two hardened washers (conforming to ASTM F436), with one washer beneath the bolt and with one washer beneath the nut. Heads of all bolts shall be on the outside face of the member as practical, unless otherwise noted. Bolt threads shall be excluded from the shear planes.
2. Maintenance platform & ladders, interfering with the new construction not shown in Road Plans shall be temporarily removed as required and reinstalled as approved by the Engineer.
3. Drain pipes to be removed as required for retrofit and reinstalled as approved by Engineer.
4. For utilities and highway facilities, such as air, water and electrical utility relocation, see Road Plans.
5. For traffic controls, see Road Plans.
6. The following symbols appear on Plan Detail sheets. They relate to various rivet replacement, drilled hole requirements, bolt/rod/stud sizes, etc., which are specified. The same symbol (e.g., Δ) may indicate a different requirement on a different sheet. Each sheet shall be a stand-alone sheet relative to symbols given in the legend and work specified.

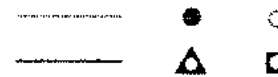

GENERAL NOTES LOAD FACTOR AND RESISTANCE DESIGN

DESIGN: BRIDGE DESIGN SPECIFICATIONS
(1983 AASHTO with Interims and Revisions by CALTRANS)
1994 AASHTO LRFD BRIDGE DESIGN SPECIFICATIONS
AND SAN FRANCISCO-OAKLAND BAY BRIDGE WEST SPANS
SEISMIC RETROFIT DESIGN CRITERIA

REINFORCED CONCRETE (NEW) Grade 60, ASTM A706
 $f'_c = 3,250$ psi

REINFORCED CONCRETE (EXISTING) $f_y = 33,000$ psi
 $f'_c = 5,000$ psi

STRUCTURAL STEEL (EXISTING) Carbon Steel
 $f_y = 37,000$ psi
 $f_u = 62,000$ psi

STRUCTURAL STEEL (NEW) ASTM A36 unless otherwise noted
 $f_y = 36,000$ psi

HIGH STRENGTH BOLTS ASTM A325 unless otherwise noted

THREADED RODS ASTM A449 unless otherwise noted

WELD E70XX unless otherwise noted

DIST.	COUNTY	ROUTE	POST MILES TOTAL PROJECT	SHEET NO.	TOTAL SHEETS
04	SF, Alameda	80	7.8/8.9, 0.0/1.1	70	205

REGISTERED ENGINEER - CIVIL
October 21, 1997

12-8-97
PLANS APPROVAL DATE

VER-FU DONALD LEE
No. 50978
Exp. 9-30-01
CIVIL
STATE OF CALIFORNIA

The State of California or its officers or agents shall not be responsible for the accuracy or completeness of electronic copies of this plan sheet.

INDEX TO PLANS

SHEET NO.	TITLE
1	GENERAL PLAN
2	INDEX TO PLANS
3	STRUCTURAL LAYOUT NO. 1
4	STRUCTURAL LAYOUT NO. 2
5	PIER YB-2
6	PIER YB-4
7	TOWER MEMBER 'CS6' AND 'CS7'
8	TOWER MEMBER 'CS10' THRU 'CS15'
9	TOWER MEMBER 'CS24' AND 'CS25'
10	TOWER MEMBER 'CS31' AND 'CS32'
11	PIER YB-3 NO. 1
12	PIER YB-3 NO. 2
13	PIER YB-3 NO. 3
14	LOWER CHORD L15-L17
15	LOWER CHORD L15A-L17A
16	LOWER CHORD L18-L20
17	LOWER CHORD L18A-L20A
18	BASE PLATE DETAILS
19	TIE ROD ASSEMBLY UNIT DETAILS
20	VERTICAL MEMBER RETROFIT MISCELLANEOUS NOTES
21	VERTICAL MEMBER DETAIL NO. 1 (NORTH)
22	VERTICAL MEMBER DETAIL NO. 2 (NORTH)
23	VERTICAL MEMBER DETAIL NO. 3 (NORTH)
24	VERTICAL MEMBER DETAIL NO. 4 (SOUTH)
25	VERTICAL MEMBER DETAIL NO. 5 (SOUTH)
26	VERTICAL MEMBER DETAIL NO. 6 (SOUTH)
27	MISCELLANEOUS DETAILS NO. 1
28	MISCELLANEOUS DETAILS NO. 2
29	MISCELLANEOUS DETAILS NO. 3
30	MISCELLANEOUS DETAILS NO. 4
31	BARRIER DETAILS NO. 1
32	BARRIER DETAILS NO. 2
33	BARRIER DETAILS NO. 3
34	BARRIER DETAILS NO. 4
35	PIER EI ANCHORAGE DETAILS NO. 1
36	PIER EI ANCHORAGE DETAILS NO. 2

STANDARD PLANS DATED JULY 1992

A10A ABBREVIATIONS

INTERIM SEISMIC RETROFIT PROJECT	
EAST BAY 288 TRUSSES YERBA BUENA ISLAND	
SAN FRANCISCO-OAKLAND BAY BRIDGE	
INDEX TO PLANS	



DESIGN	BY E. A. Morris	CHECKED Don Lee	STATE OF CALIFORNIA DEPARTMENT OF TRANSPORTATION	DIVISION OF STRUCTURES STRUCTURE DESIGN TOLL BRIDGES SPECIAL ANALYSIS	BRIDGE NO.	33-0025	SAN FRANCISCO-OAKLAND BAY BRIDGE INDEX TO PLANS
DETAILS	BY Janie Chubna	CHECKED Don Lee			POST MILE	1.5	
QUANTITIES	BY E. A. Morris	CHECKED Don Lee					
ORIGINAL SCALE IN INCHES FOR REDUCED PLANS				CU 04 EA 043001	REVISION DATES (PRELIMINARY STAGE ONLY)		SHEET 2 OF 36

DIST.	COUNTY	ROUTE	POST MILES TOTAL PROJECT	SHEET NO.	TOTAL SHEETS
04	SF, Alameda	80	7.8/8.9, 0.0/1.1	71	205


REGISTERED ENGINEER - CIVIL
October 21, 1997

12-8-97
PLANS APPROVAL DATE

The State of California or its officers or agents shall not be responsible for the accuracy or completeness of electronic copies of this plan sheet.

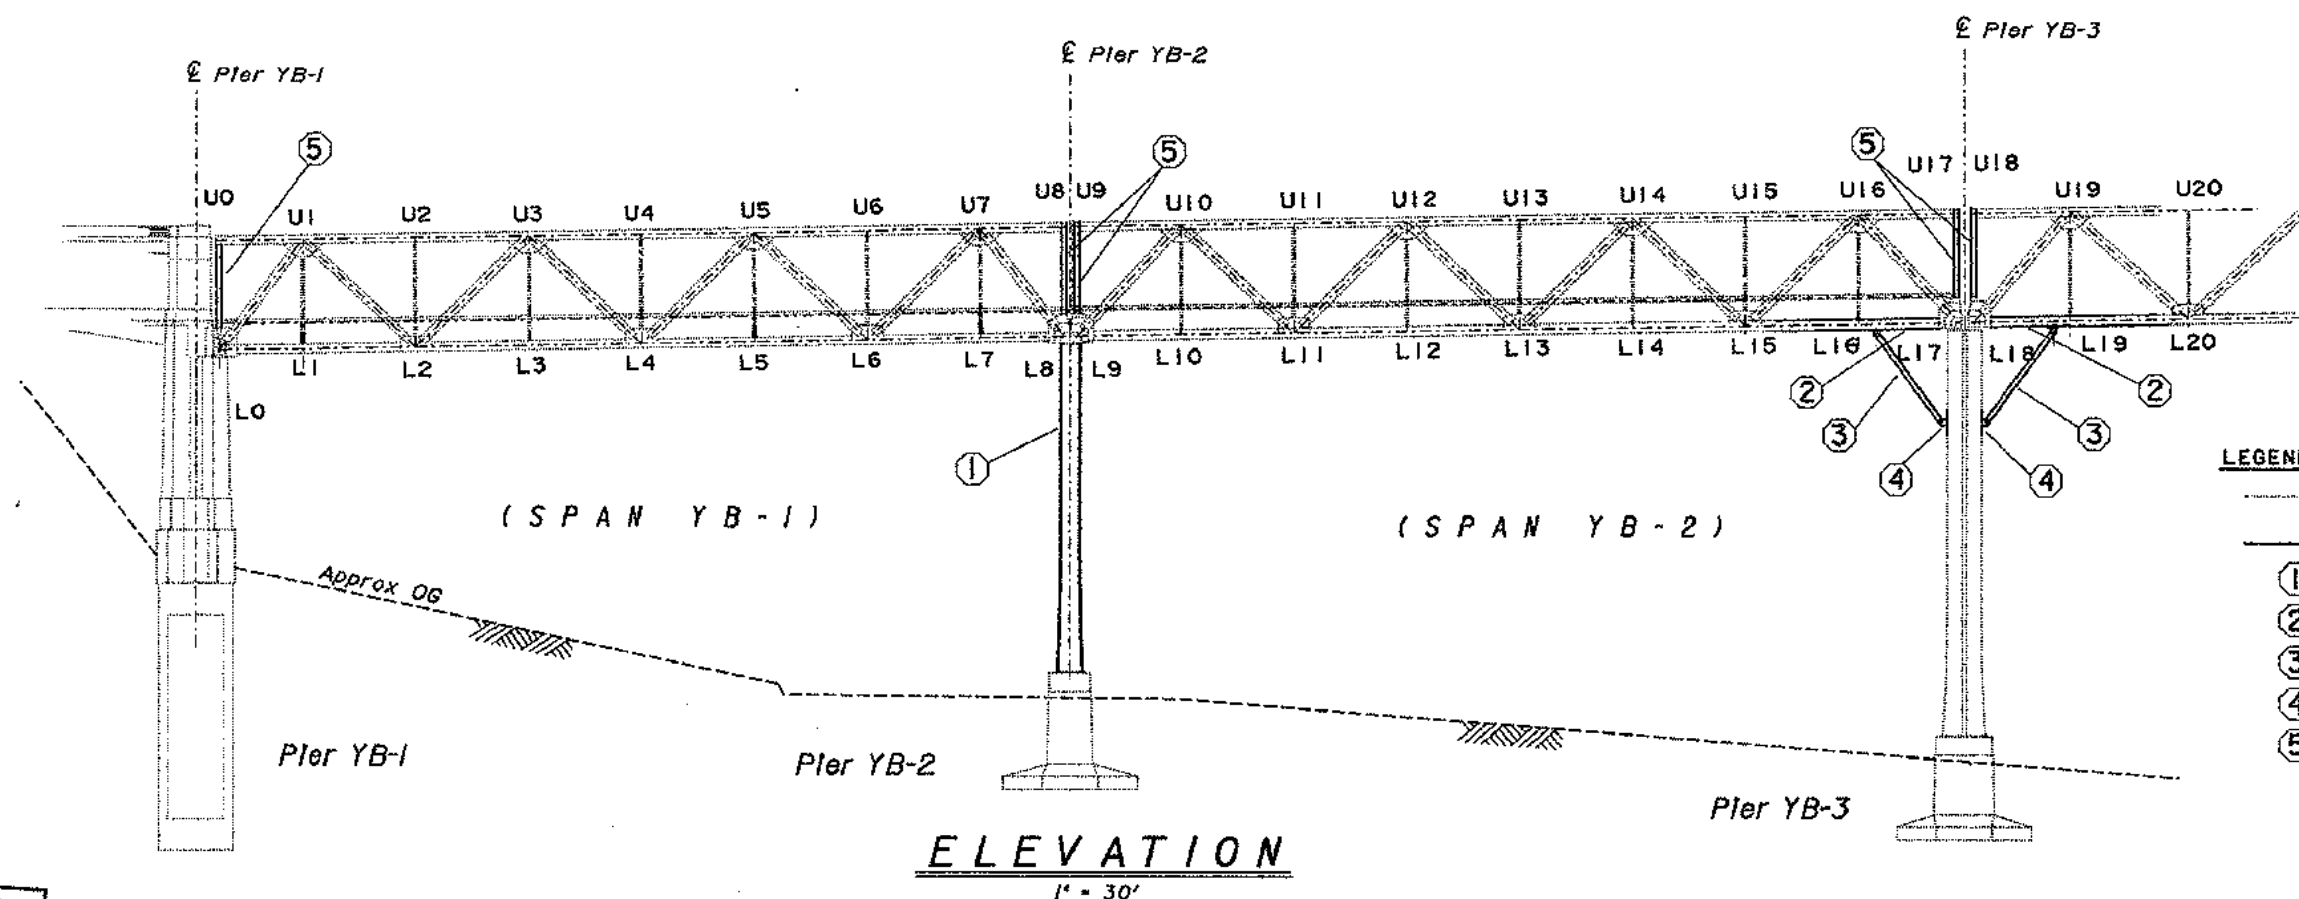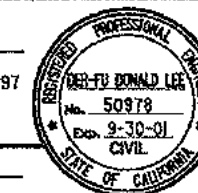

- LEGEND**
- Indicates Existing Structure
 - Indicates New Construction
 - ① Indicates Tower Member Retrofit
 - ② Indicates Lower Chord Retrofit
 - ③ Indicates Add Vertical Bracing Member
 - ④ Indicates Tower Connection Retrofit
 - ⑤ Indicates Vertical Member Retrofit

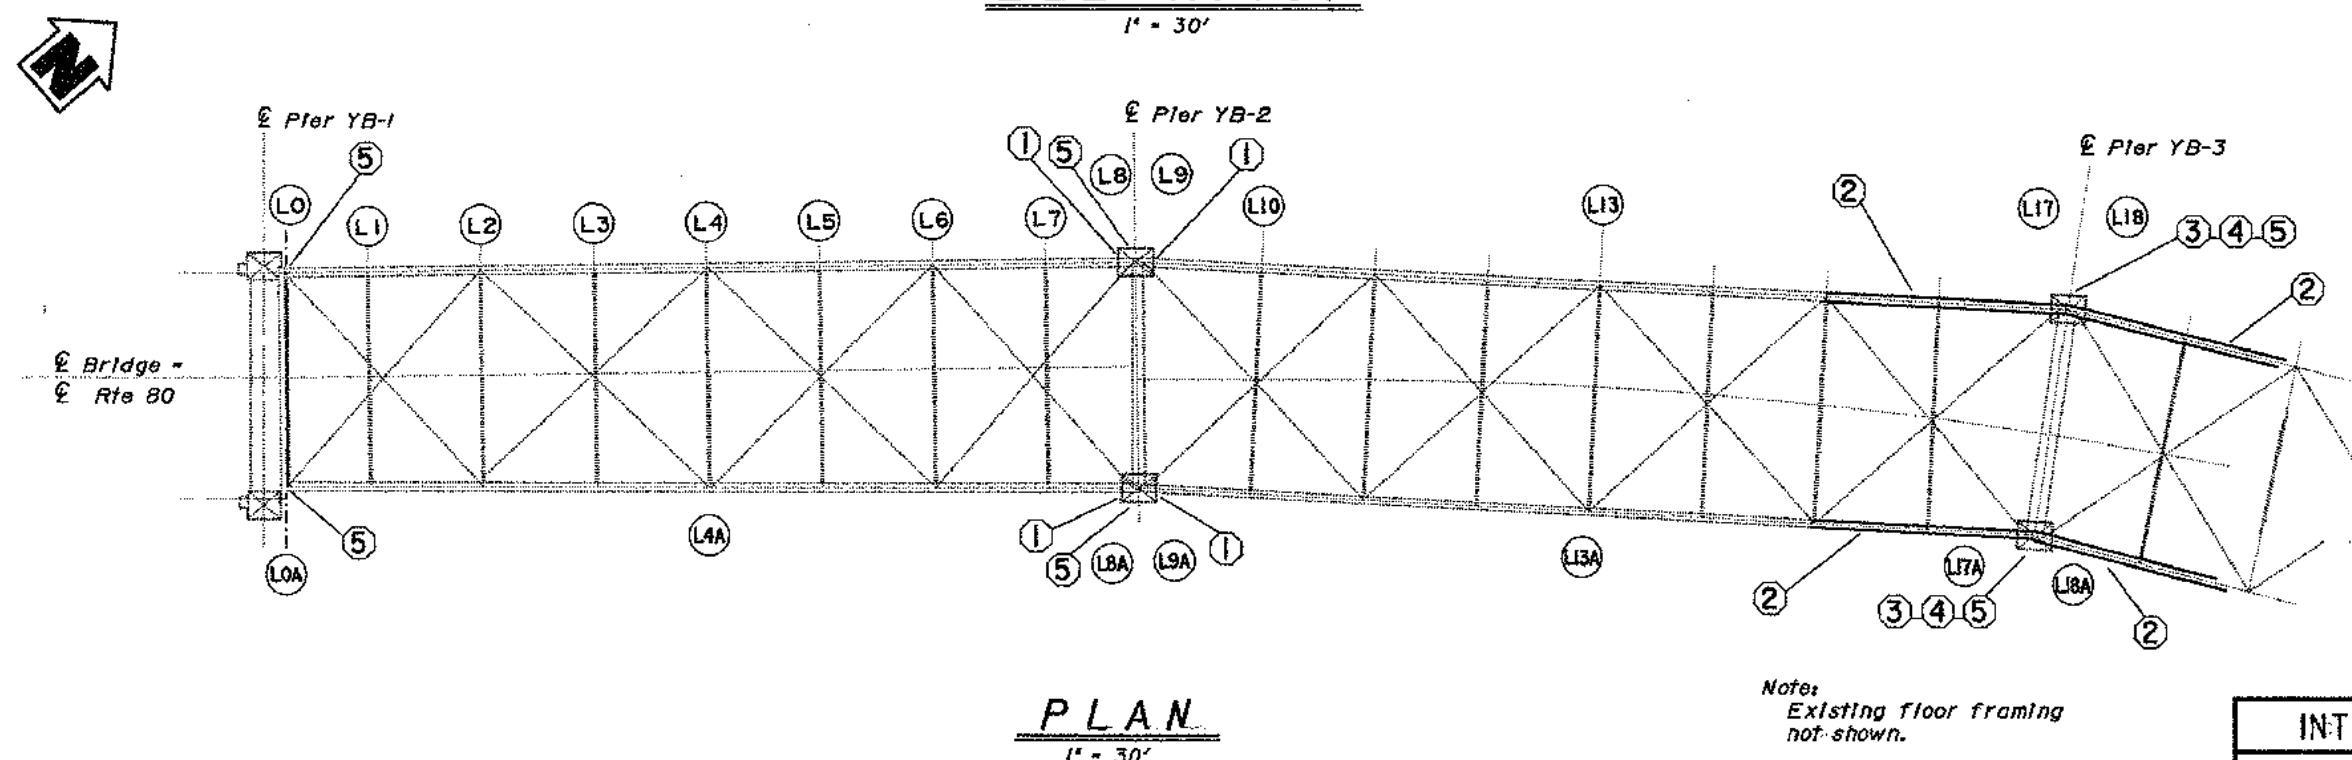

Note:
Existing floor framing
not shown.

INTERIM SEISMIC RETROFIT PROJECT
EAST BAY 288 TRUSSES YERBA BUENA ISLAND
SAN FRANCISCO-OAKLAND BAY BRIDGE
STRUCTURAL LAYOUT NO. 1

DESIGN	BY E.A. Morris	5-97	CHECKED Don Lee	5-97
DETAILS	BY Ralph Nakagawa	5-97	CHECKED Don Lee	5-97
QUANTITIES	BY E.A. Morris	5-97	CHECKED Don Lee	5-97

STATE OF CALIFORNIA
DEPARTMENT OF TRANSPORTATION

DIVISION OF STRUCTURES
STRUCTURE DESIGN
TOLL BRIDGE SPECIAL ANALYSIS

BRIDGE NO.	33-0025
POST MILE	1.5

CU 04
EA 043001


DISCARD PRINTS BEARING EARLIER REVISION DATES	REVISION DATES (PRELIMINARY STAGE ONLY)	SHEET 3 OF 36
---	---	---------------

DIST.	COUNTY	ROUTE	POST MILES TOTAL PROJECT	SHEET NO.	TOTAL SHEETS
04	SF, Alameda	80	7.8/8.9, 0.0/1.1	72	205

REGISTERED ENGINEER - CIVIL
 October 24, 1997
 12-8-97
 PLANS APPROVAL DATE


THE STATE OF CALIFORNIA
 REGISTERED PROFESSIONAL ENGINEER
 DONALD LEE
 No. 50978
 Exp. 9-30-01
 CIVIL
 STATE OF CALIFORNIA

The State of California or its officers or agents shall not be responsible for the accuracy or completeness of electronic copies of this plan sheet.

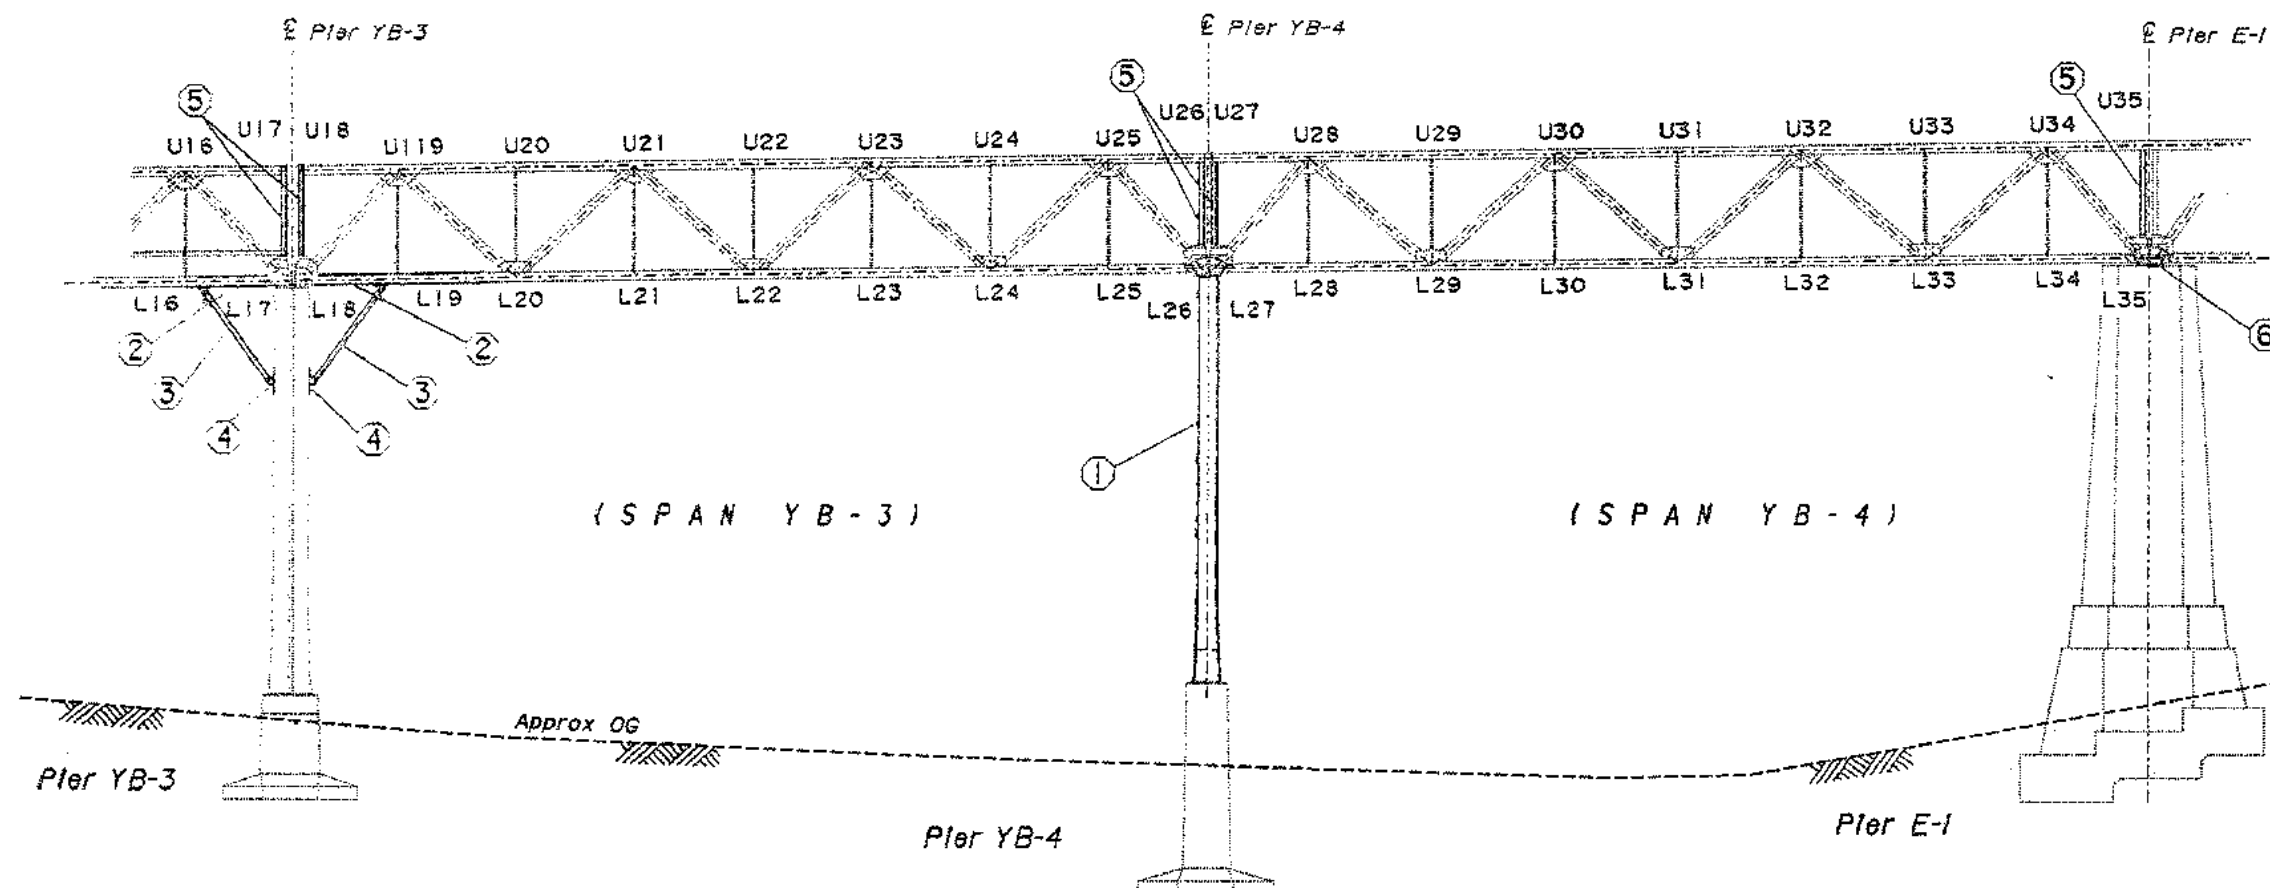

ELEVATION
1" = 30'

- LEGEND**
- Indicates Existing Structure
 - Indicates New Construction
 - ① Indicates Tower Member Retrofit
 - ② Indicates Lower Chord Retrofit
 - ③ Indicates Add Vertical Bracing Member
 - ④ Indicates Tower Connection Retrofit
 - ⑤ Indicates Vertical Member Retrofit
 - ⑥ Indicates Truss Support Retrofit

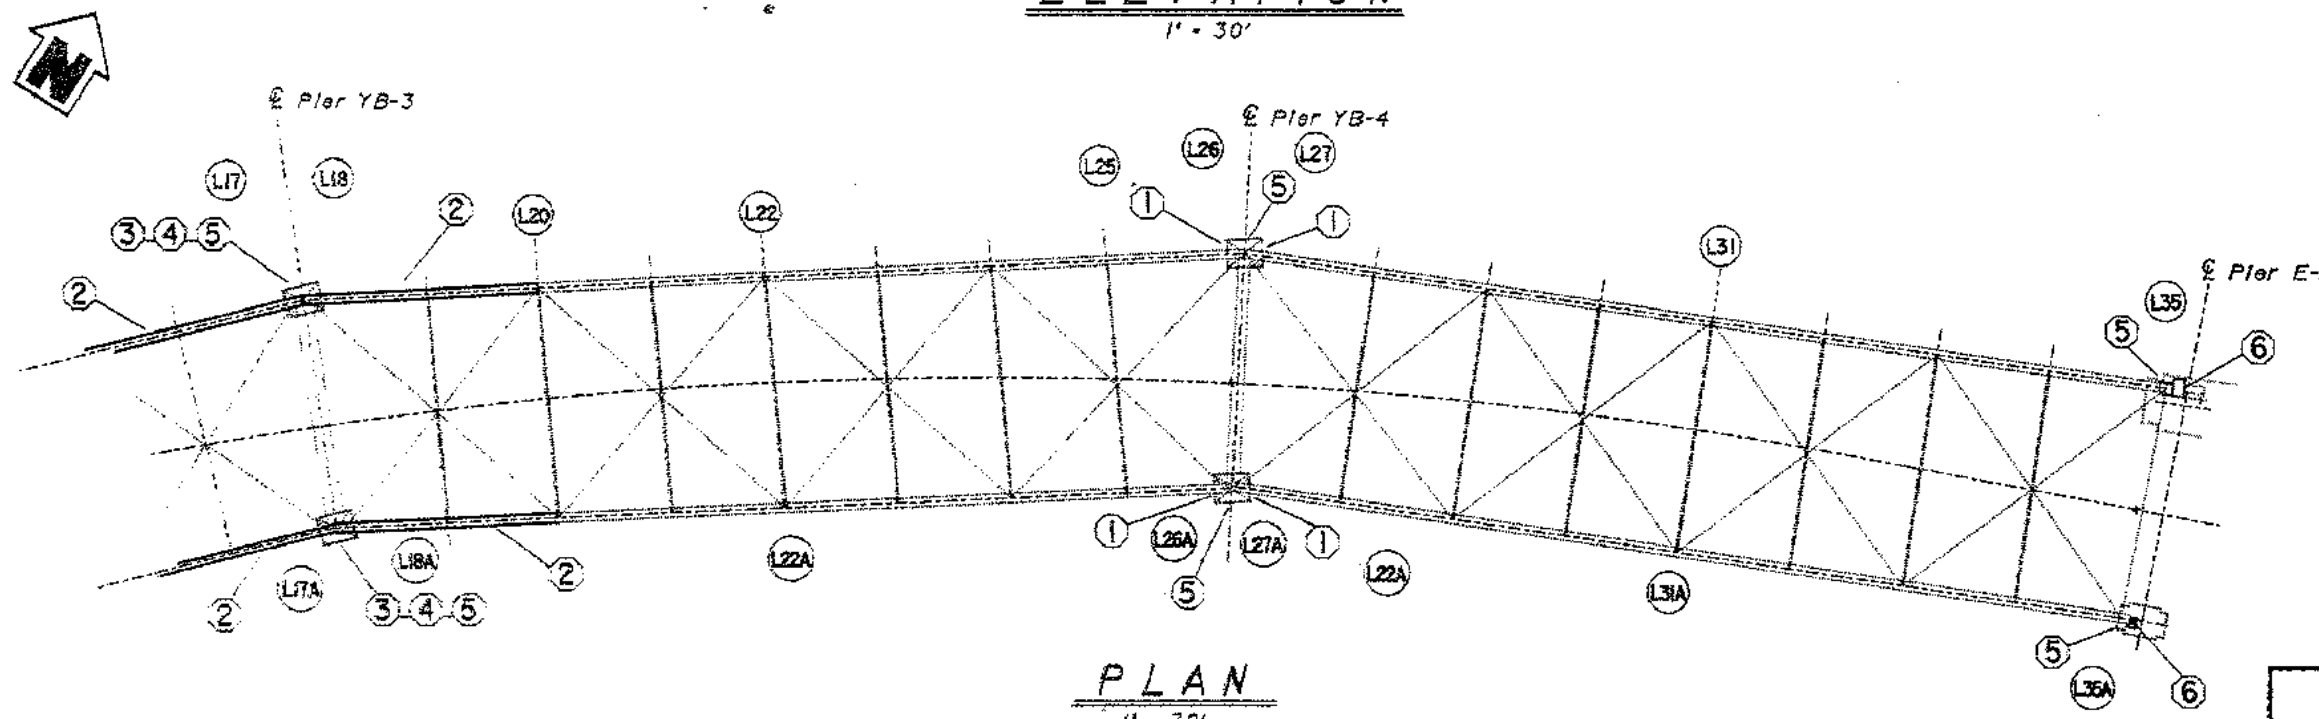

PLAN
1" = 30'

Note:
Existing floor framing
not shown.

INTERIM SEISMIC RETROFIT PROJECT	
EAST BAY 288 TRUSSES YERBA BUENA ISLAND	
SAN FRANCISCO-OAKLAND BAY BRIDGE	
STRUCTURAL LAYOUT NO. 2	

DESIGN	BY E.A. Morris 5-97	CHECKED Don Lee 5-97
DETAILS	BY Ralph Nakagawa 5-97	CHECKED Don Lee 5-97
QUANTITIES	BY E.A. Morris 5-97	CHECKED Don Lee 5-97

STATE OF CALIFORNIA	DIVISION OF STRUCTURES	BRIDGE NO. 33-0025
DEPARTMENT OF TRANSPORTATION	STRUCTURE DESIGN	POST MILE 1.5
	TOLL BRIDGE SPECIAL ANALYSIS	

DIST.	COUNTY	ROUTE	POST MILES TOTAL PROJECT	SHEET NO.	TOTAL SHEETS
04	SF, Alameda	80	7.8/8.9, 0.0/1.1	74	205

REGISTERED ENGINEER - CIVIL
October 21, 1997

12-8-97
PLANS APPROVAL DATE

The State of California or its officers or agents shall not be responsible for the accuracy or completeness of electronic copies of this plan sheet.

LEGEND


- Indicates Existing Structures
- Indicates New Construction

ANNOTATION


- TPCPE - Tower Perforated Cover Plate East Side
- TPCPW - Tower Perforated Cover Plate West Side

CONSTRUCTION NOTES:

- Batten removal shall be performed on only one face of one tower leg per pier at a time.
- The maximum unbraced length between tower leg angles shall not exceed 40 feet at any time.
- During construction recess longer than 6 hours, Tower leg angles shall be braced at maximum of 10 feet intervals.

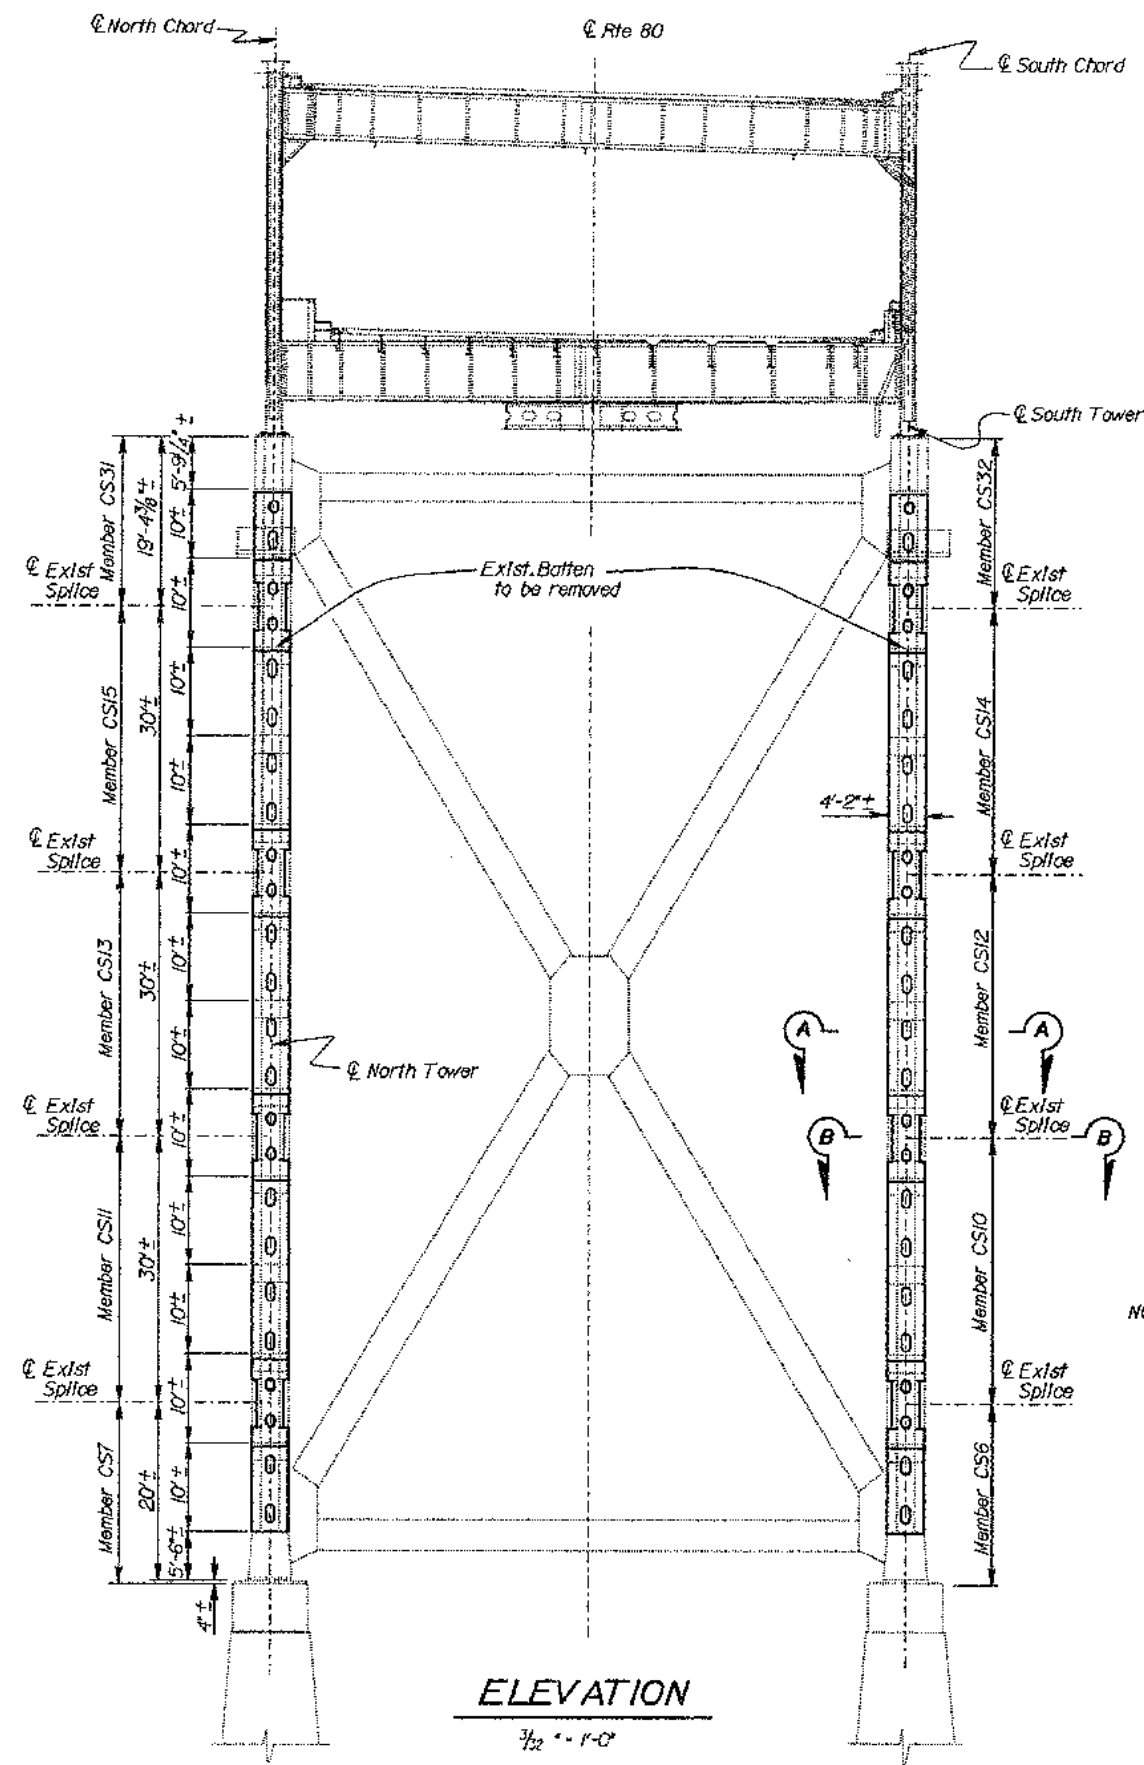


NOTE:
For details not shown see
Tower Member 'CS6' and 'CS7'
Tower Member 'CS10' thru 'CS15',
Tower Member 'CS31' and 'CS32',
and 'Vertical Member Detail' sheets.

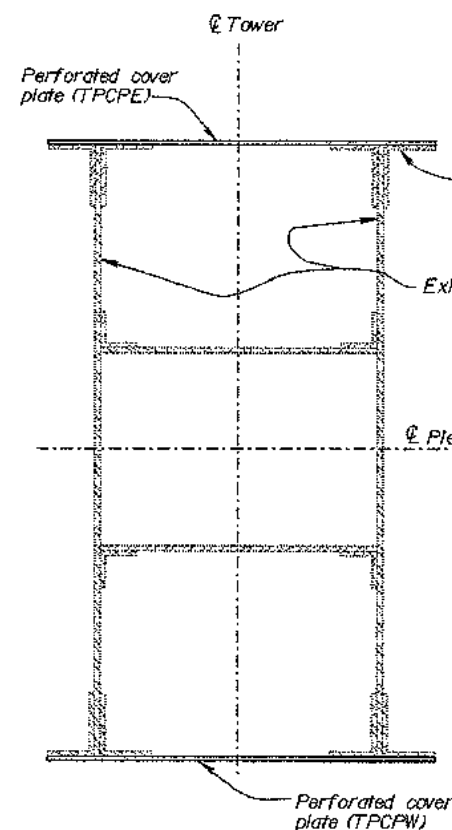

SECTION A-A

NOTE:
THE CONTRACTOR SHALL VERIFY ALL CONTROLLING FIELD DIMENSIONS BEFORE ORDERING OR FABRICATING ANY MATERIAL.

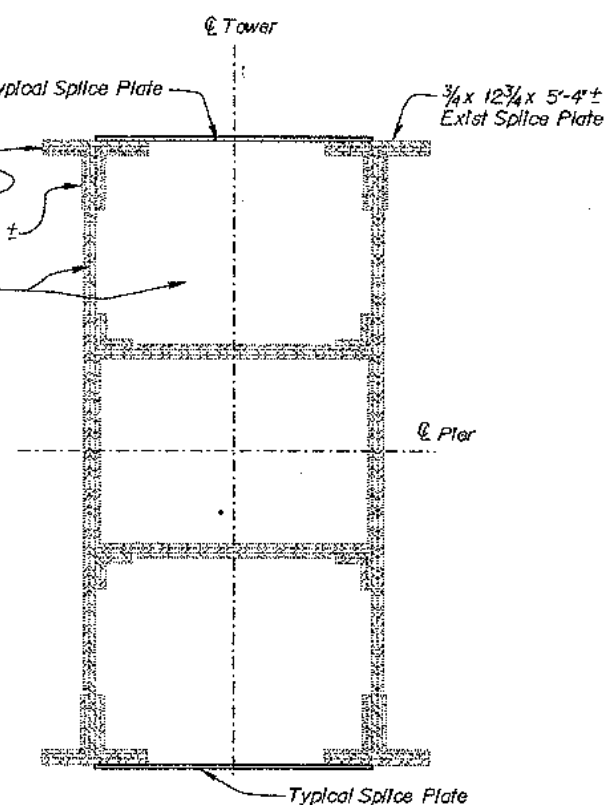

SECTION B-B

INTERIM SEISMIC RETROFIT PROJECT
EAST BAY 288 TRUSSES YERBA BUENA ISLAND
SAN FRANCISCO-OAKLAND BAY BRIDGE
PIER YB-4

DESIGN	BY Don Lee	CHECKED Fadel Alameddine
DETAILS	BY Janie Chubno	CHECKED Fadel Alameddine
QUANTITIES	BY Don Lee	CHECKED Fadel Alameddine

STATE OF CALIFORNIA
DEPARTMENT OF TRANSPORTATION

DIVISION OF STRUCTURES
STRUCTURE DESIGN
TOLL BRIDGES SPECIAL ANALYSIS

BRIDGE NO.	33-0025
POST MILE	1.5

DISREGARD PRINTS BEARING EARLIER REVISION DATES

REVISION DATES (PRELIMINARY STAGE OR 1)										SHEET	OF
5-2-97	5-2-97	5-2-97	5-2-97	5-2-97	5-2-97	5-2-97	5-2-97	5-2-97	5-2-97	6	36

NOTE:
THE CONTRACTOR SHALL VERIFY ALL
CONTROLLING FIELD DIMENSIONS
BEFORE ORDERING OR FABRICATING
ANY MATERIAL.

ANNOTATION

TPCPE - Tower Perforated Cover
Plate East Side
TPCPW - Tower Perforated Cover
Plate West Side

LEGEND



- Indicates existing structures.
- Indicates new construction.
- Indicates new 1" ϕ high strength bolts.
- ▲ Indicates existing 1" ϕ rivets to be removed and replaced with new 1" ϕ high strength bolts.
- Indicates approx. location of existing rivets
- Indicates location of existing rivets where head of rivet is to be removed flush with face of the angle, rest of rivet to remain.
- ▨ Indicates limits of steel removal.

DIST.	COUNTY	ROUTE	POST MILES TOTAL PROJECT	SHEET NO.	TOTAL SHEETS
04	SF, Alameda	80	7.8/8.9, 0.0/1.1	76	205

REGISTERED ENGINEER - CIVIL
October 21, 1997

12-8-97
PLANS APPROVAL DATE

The State of California or its officers or agents shall not be responsible for the accuracy or completeness of electronic copies of this plan sheet.

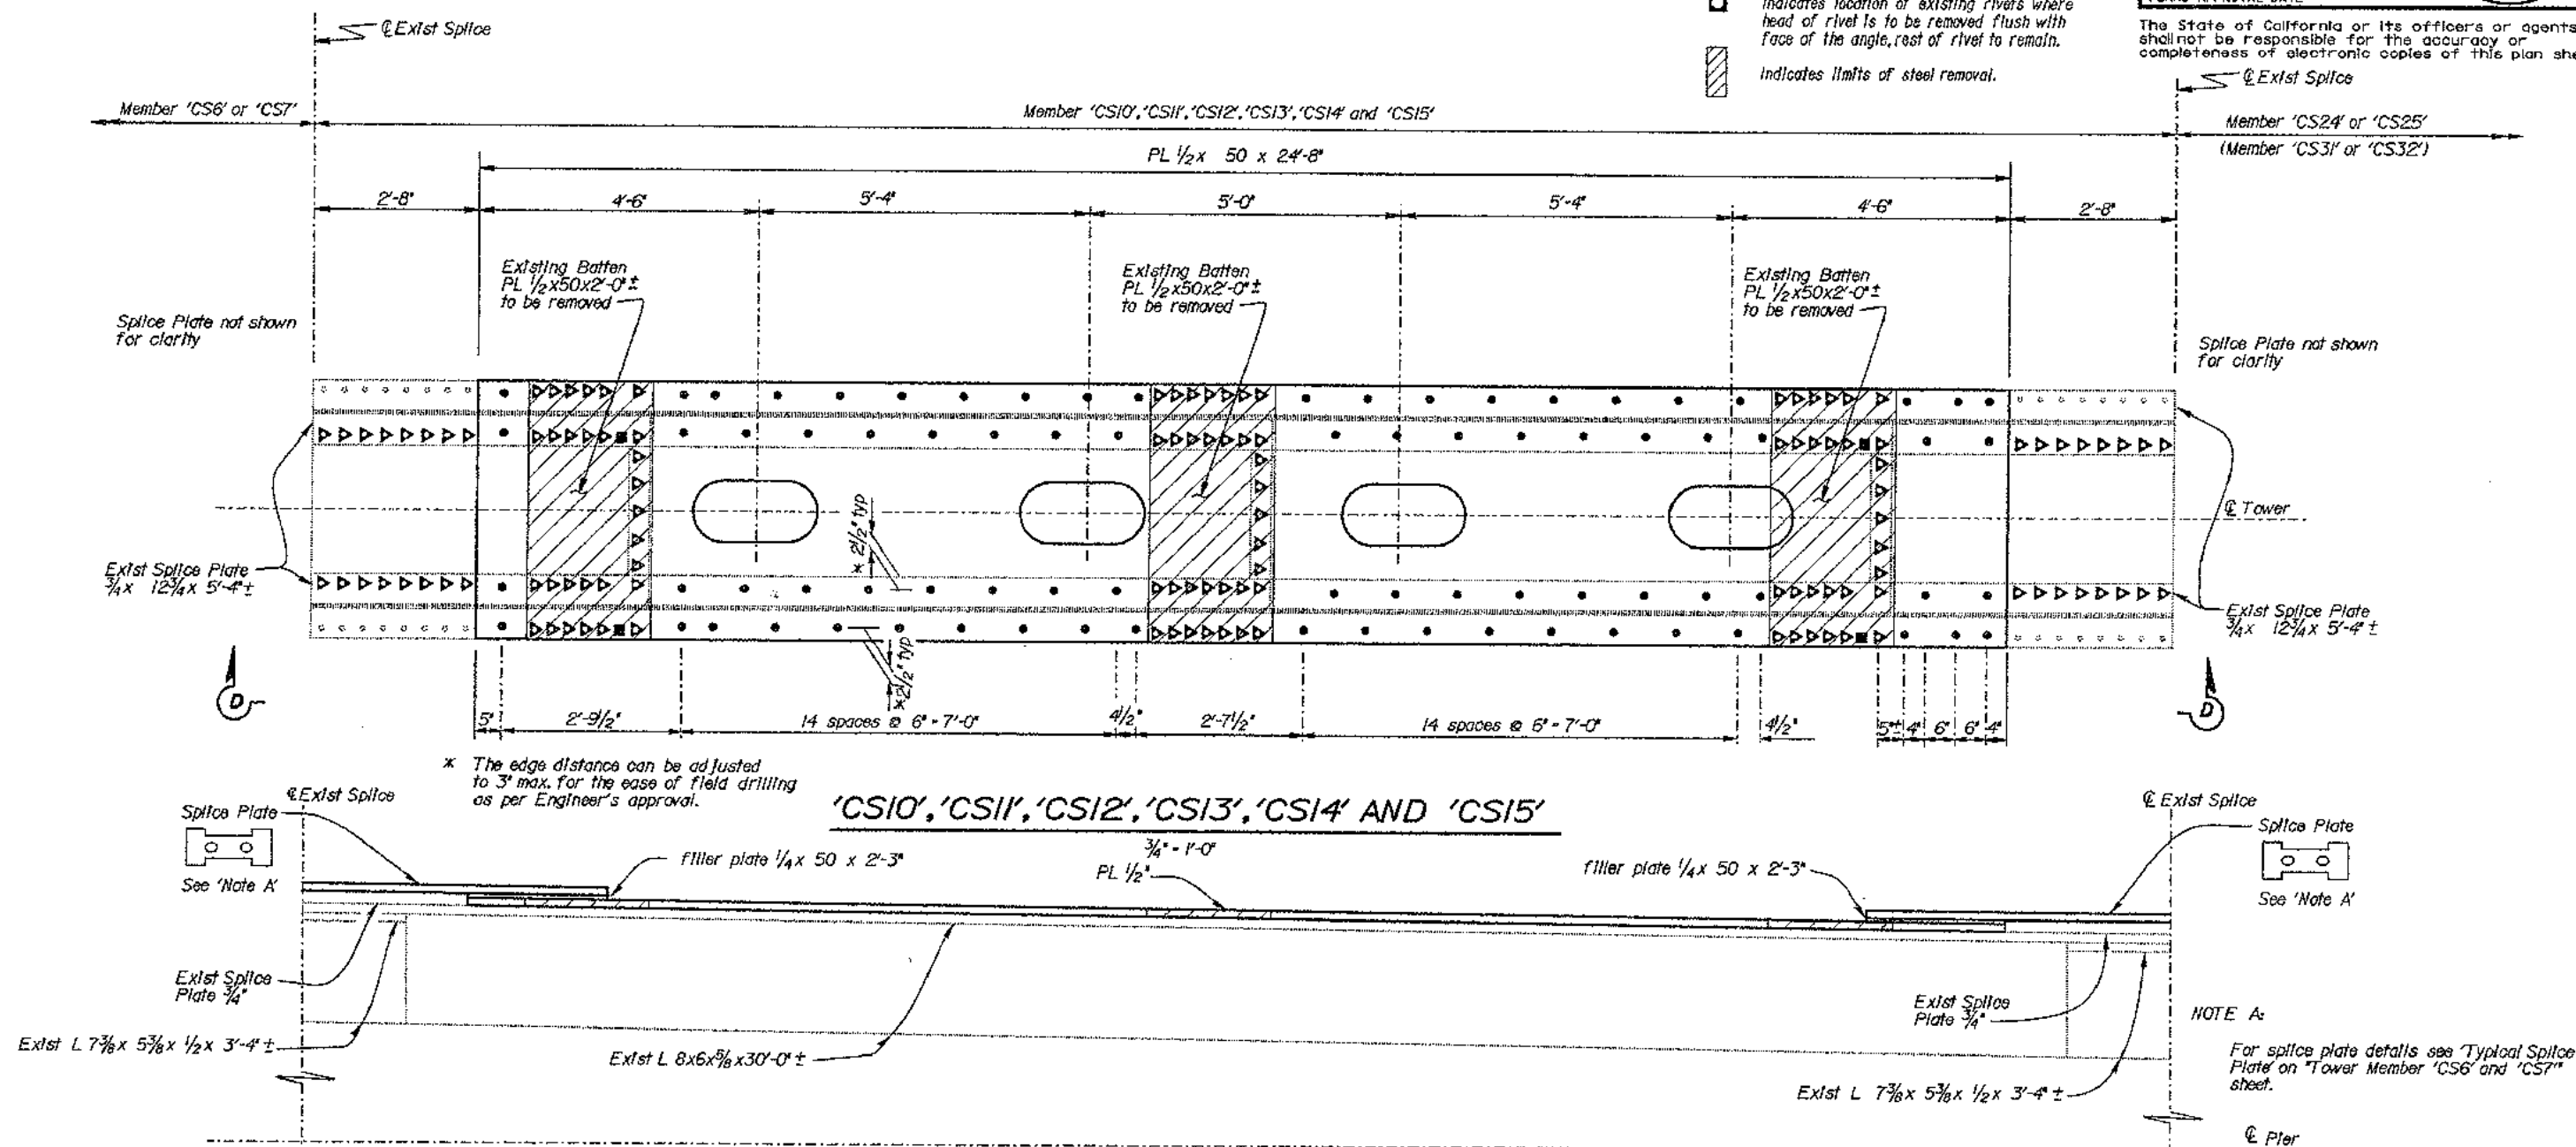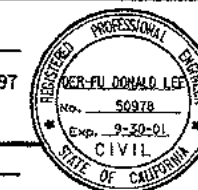

PART VIEW D-D

Horiz. = 3/4" = 1'-0"
Vert. = 3" = 1'-0"

NOTE:

('CS10' and 'CS11' shown 'CS12', 'CS13',
'CS14' and 'CS15' similar)

NOTES:

All details not shown in 'Part View D-D'.

Details shown symmetric about ϕ Pier.

TPCPW side shown, TPCPE side similar.
For location see 'Pier YB-2' and 'Pier YB-4' sheets.

All bolts not shown for clarity.

INTERIM SEISMIC RETROFIT PROJECT

EAST BAY 288 TRUSSES YERBA BUENA ISLAND

SAN FRANCISCO-OAKLAND BAY BRIDGE

TOWER MEMBER 'CS10' THRU 'CS15'

DESIGN	BY Don Lee	CHECKED Fadel Alameddine	STATE OF CALIFORNIA	DIVISION OF STRUCTURES	BRIDGE NO. 33-0025
DETAILS	BY Janie Chubna	CHECKED Fadel Alameddine	DEPARTMENT OF TRANSPORTATION	STRUCTURE DESIGN	POST MILE 1.5
QUANTITIES	BY Don Lee	CHECKED Fadel Alameddine		TOLL BRIDGES SPECIAL ANALYSIS	
ORIGINAL SCALE IN INCHES FOR REDUCED PLANS			CU 04	EA 043001	DISREGARD PRINTS BEARING EARLIER REVISION DATES
			USERNAME => fmkkes1 bepir08rm2..09071009		

DATE PLOTTED => 9-Dec-1997
TIME PLOTTED => 07:17

NOTE:
THE CONTRACTOR SHALL VERIFY ALL
CONTROLLING FIELD DIMENSIONS
BEFORE ORDERING OR FABRICATING
ANY MATERIAL.

DIST.	COUNTY	ROUTE	POST MILES TOTAL PROJECT	SHEET NO.	TOTAL SHEETS
04	SF. Alca	80	7.8/8.9, 0.0/1.1	77	205

REGISTERED ENGINEER - CIVIL
October 21, 1997

12-8-97
PLANS APPROVAL DATE

The State of California or its officers or agents
shall not be responsible for the accuracy or
completeness of electronic copies of this plan sheet.

LEGEND

- Indicates existing structures.
- Indicates new construction.
- Indicates new 1" ϕ high strength bolts.
- ▲ Indicates existing 1" ϕ rivets to be removed and replaced with new 1" ϕ high strength bolts.
- Indicates approx. location of existing rivets.
- Indicates location of existing rivets where head of rivet is to be removed flush with face of the angle, rest of rivet to remain.
- ▨ Indicates limits of steel removal.

ANNOTATION

TPCPE - Tower Perforated Cover
Plate East Side
TPCPW - Tower Perforated Cover
Plate West Side

NOTE:


Existing platform, not shown, shall be temporarily detached, supported, and reinstalled on the new cover plate as per Engineer's approval.

NOTE A:

For Splice plate details see 'Typical Splice Plate' details on 'Tower Member 'CS6' and 'CS7' sheet.

NOTES:

All details not shown in 'Part View E-E'.
Details shown symmetric about ϕ Pter.
TPCPW side shown, TPCPE side similar.
For locations see 'Pier YB-2' sheet.
All bolts not shown for clarity.

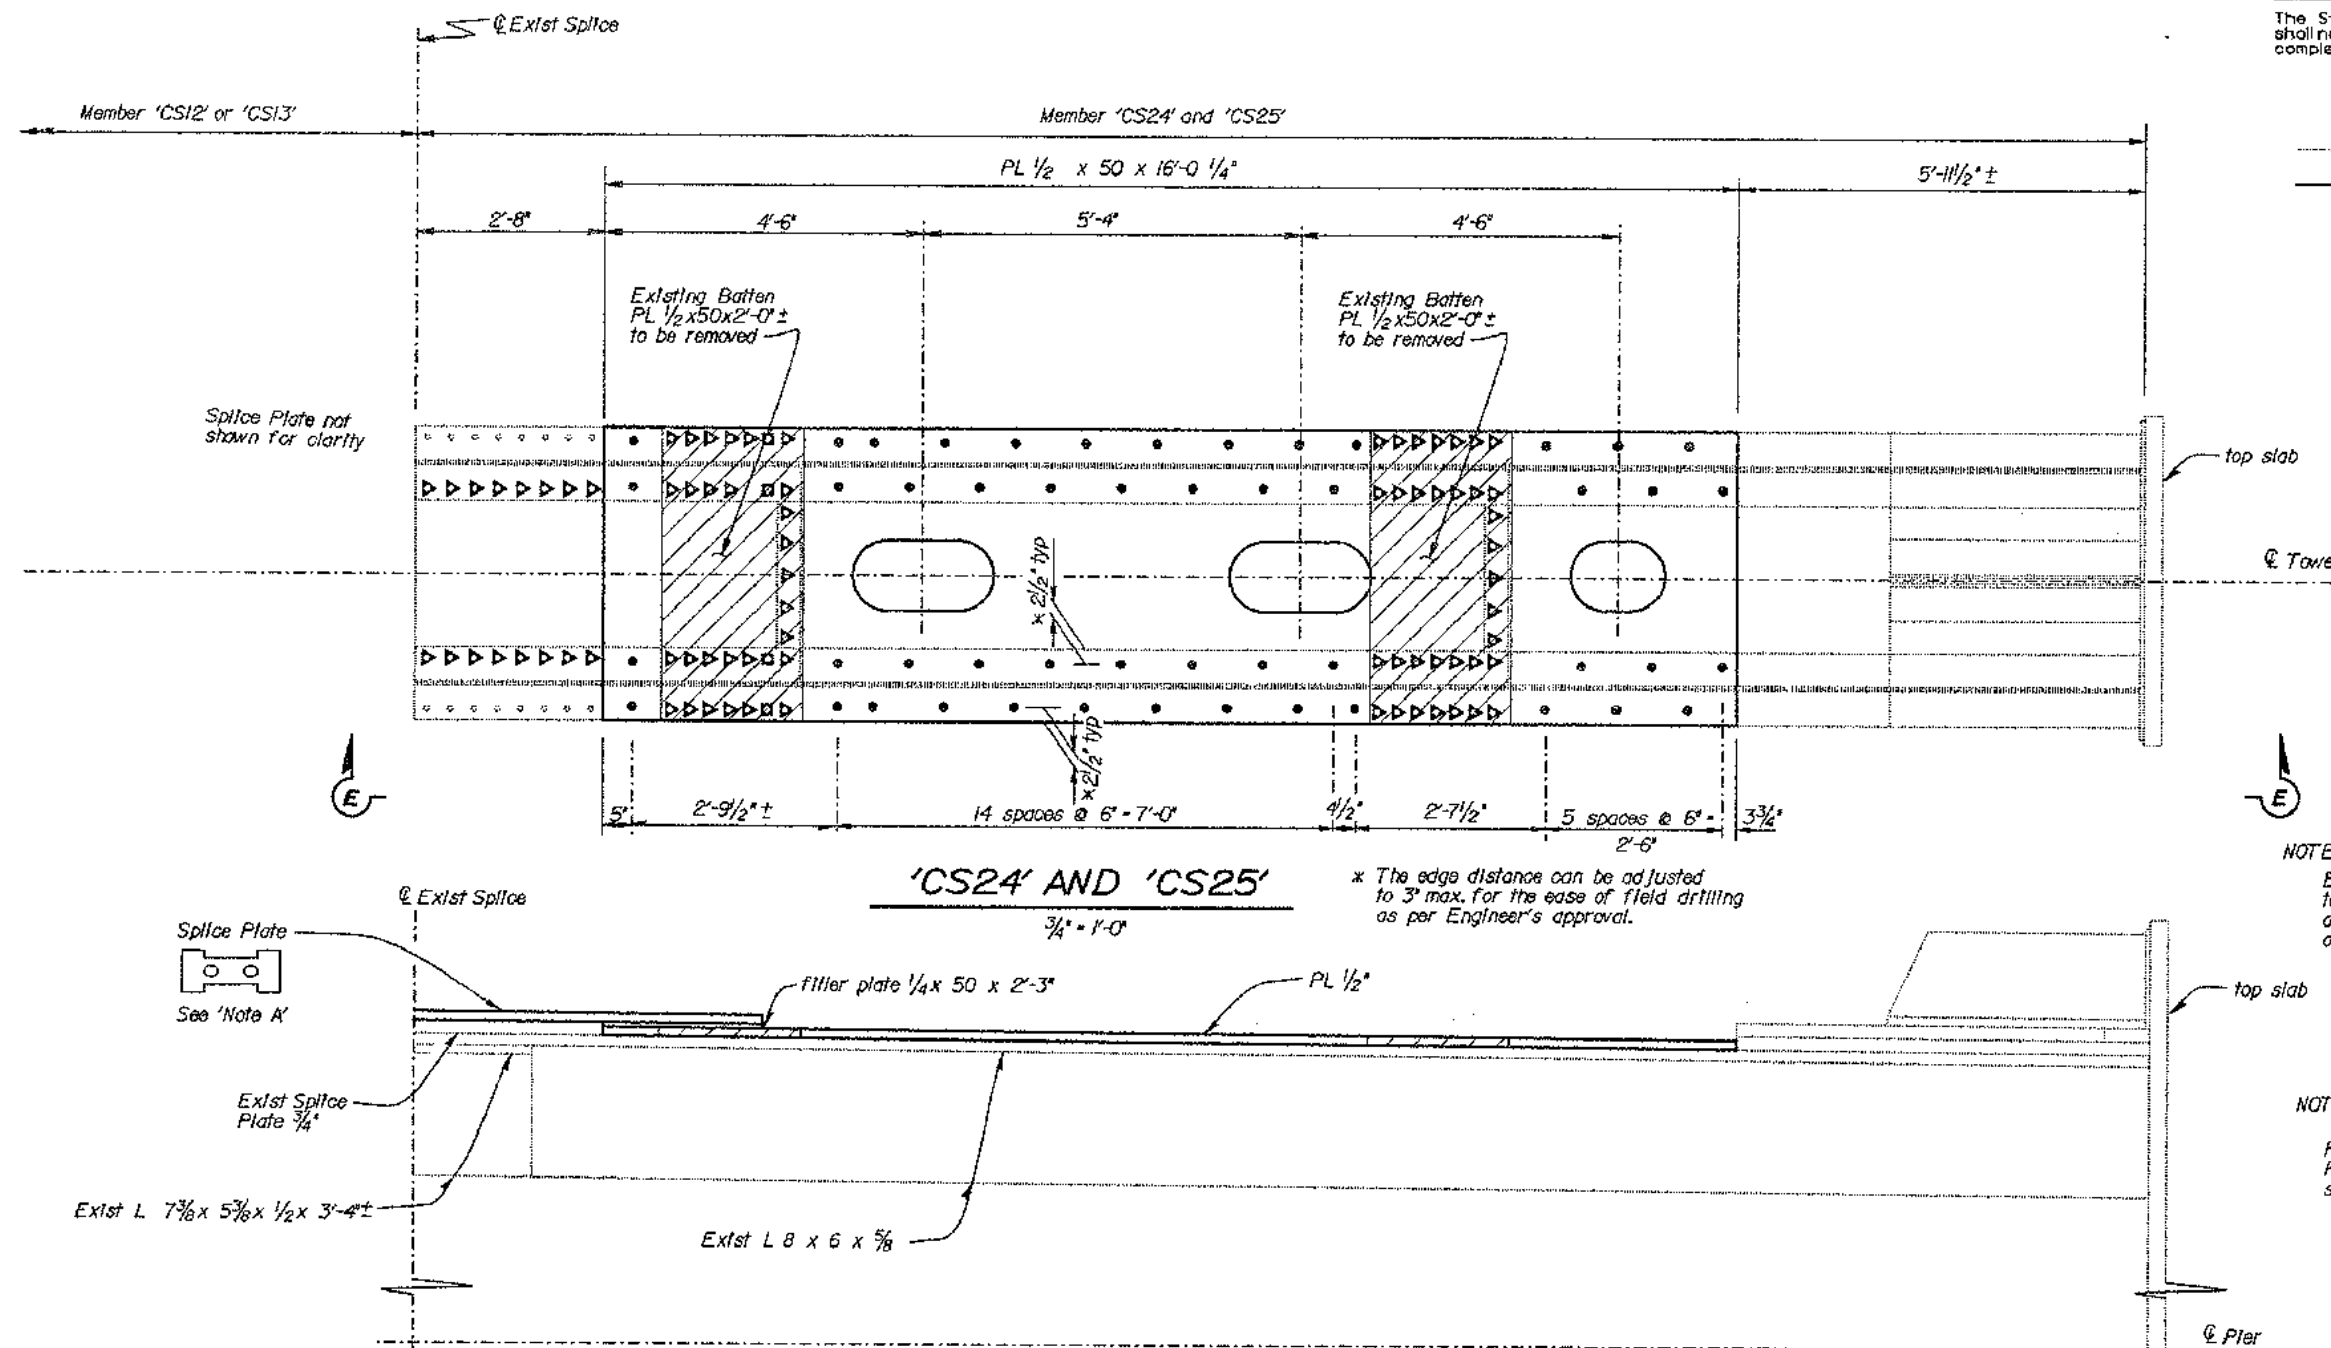

PART VIEW E-E

Horiz. = 3/4" = 1'-0"
Vert. = 3" = 1'-0"

INTERIM SEISMIC RETROFIT PROJECT
EAST BAY 288 TRUSSES YERBA BUENA ISLAND
SAN FRANCISCO-OAKLAND BAY BRIDGE
TOWER MEMBER 'CS24' AND 'CS25'

DESIGN	BY E. A. Morris	CHECKED Fadel Alameddine
DETAILS	BY Janie Chlubna	CHECKED Fadel Alameddine
QUANTITIES	BY Don Lee	CHECKED Fadel Alameddine

STATE OF
CALIFORNIA
DEPARTMENT OF TRANSPORTATION

DIVISION OF STRUCTURES
STRUCTURE DESIGN
TOLL BRIDGES SPECIAL ANALYSIS

BRIDGE NO.
33-0025
POST MILE
1.5

OS 050 2338 (CADD 9/90)

ORIGINAL SCALE IN INCHES
FOR REDUCED PLANS

CU 04
EA 043001

DISREGARD PRINTS BEARING
EARLIER REVISION DATES

REVISION DATES (PRELIMINARY STAGE ONLY)

NO.	DATE	DESCRIPTION	BY	CHKD
1	5-20-97	5-20-97	5-20-97	5-20-97
2	5-20-97	5-20-97	5-20-97	5-20-97
3	5-20-97	5-20-97	5-20-97	5-20-97
4	5-20-97	5-20-97	5-20-97	5-20-97
5	5-20-97	5-20-97	5-20-97	5-20-97
6	5-20-97	5-20-97	5-20-97	5-20-97
7	5-20-97	5-20-97	5-20-97	5-20-97
8	5-20-97	5-20-97	5-20-97	5-20-97
9	5-20-97	5-20-97	5-20-97	5-20-97
10	5-20-97	5-20-97	5-20-97	5-20-97

USERNAME => trmikesi
dep1r09rm3_09071017

DATE PLOTTED => 9-06-1997
TIME PLOTTED => 07:19

DIST.	COUNTY	ROUTE	POST MILES TOTAL PROJECT	SHEET NO.	TOTAL SHEETS
04	SF, Alameda	80	7.8/8.9, 0.0/1.1	78	205

REGISTERED ENGINEER - CIVIL
October 21, 1997

12-8-97
PLANS APPROVAL DATE

The State of California or its officers or agents shall not be responsible for the accuracy or completeness of electronic copies of this plan sheet.

LEGEND

- Indicates existing structures.
- Indicates new construction.
- Indicates new 1" high strength bolts.
- Indicates existing 1" rivets to be removed and replaced with new 1" high strength bolts.
- Indicates approx. location of existing rivets.
- Indicates location of existing rivets where head of rivet is to be removed flush with face of the angle, rest of rivet to remain.
- Indicates limits of steel removal.

ANNOTATION

- TPCPE - Tower Perforated Cover Plate East Side
- TPCPW - Tower Perforated Cover Plate West Side

NOTE:

Existing platform, not shown, shall be temporarily detached, supported, and reinstalled on the new cover plate as per Engineer's approval.

NOTE A:

For splice plate details see Typical Splice Plate on Tower Member 'CS6' and 'CS7' sheet.

NOTES:

- All details not shown in 'Part View F-F'.
- Details shown symmetric about @Pier.
- TPCPW side shown, TPCPE side similar. For location see 'Pier YB-4' sheet.
- All bolts not shown for clarity.

NOTE:

THE CONTRACTOR SHALL VERIFY ALL CONTROLLING FIELD DIMENSIONS BEFORE ORDERING OR FABRICATING ANY MATERIAL.

PART VIEW F-F

Horiz. = 3/4" = 1'-0"
Vert. = 3" = 1'-0"

				DESIGN	BY	Don Lee	CHECKED	Fadel Alameddine	STATE OF CALIFORNIA DEPARTMENT OF TRANSPORTATION	DIVISION OF STRUCTURES STRUCTURE DESIGN TOLL BRIDGES SPECIAL ANALYSIS	BRIDGE NO.	33-0025	SAN FRANCISCO-OAKLAND BAY BRIDGE TOWER MEMBER 'CS31' AND 'CS32'														
				DETAILS	BY	Janie Chlubna	CHECKED	Fadel Alameddine			POST MILE	1.5															
				QUANTITIES	BY	Don Lee	CHECKED	Fadel Alameddine																			
DS 050 239 (CADD 9/95)								ORIGINAL SCALE IN INCHES FOR REDUCED PLANS		0	1	2	3	CU 04 EA 043001	DISREGARD PRINTS BEARING EARLIER REVISION DATES	REVISION DATES (PRELIMINARY STAGE ONLY)				5-3-87	10-23-87	5-4-87	5-4-87	5-27-87	3-2-87	10-23-87	SHEET 10 OF 36

DS 050 209 (CADD 9/95)

ORIGINAL SCALE IN INCHES FOR REDUCED PLANS

USERNAME => trmikes
bopir10tm4_09071025

DATE PLOTTED => 9-Dec-1997
TIME PLOTTED => 07:21


Dezel
REGISTERED ENGINEER - CIVIL
October 21, 1997

12-8-97
PLANS APPROVAL DATE

REGISTERED PROFESSIONAL ENGINEER
FOR DONALD LEE
No. 50978
Exp. 9-30-01
CIVIL
STATE OF CALIFORNIA

LEGEND

- NOTE:
THE CONTRACTOR SHALL VERIFY ALL
CONTROLLING FIELD DIMENSIONS
BEFORE ORDERING OR FABRICATING
ANY MATERIAL.

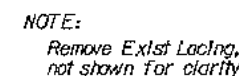

NOTES:
For 'View B-B' see 'Pier YB-3 No. 3' sheet.
For layout of new HS bolts see 'View D-D' on 'Pier YB-3 No. 3' sheet.

ELEVATION

$$3/2 = 1.5$$


DESIGN	BY Fadel Alameddine	CHECKED E. A. Morris
DETAILS	BY Janie Chubna	CHECKED E. A. Morris
QUANTITIES	BY Fadel Alameddine	CHECKED E. A. Morris

STATE OF
CALIFORNIA
DEPARTMENT OF TRANSPORTATION

DIVISION OF STRUCTURES STRUCTURE DESIGN

BRIDGE NO.
33-0025
POST MILE
1.5

INTERIM SEISMIC RETROFIT PROJECT
EAST BAY 288 TRUSSES YERBA BUENA ISLAND
SAN FRANCISCO-OAKLAND BAY BRIDGE
PIER YB-3 NO. 1

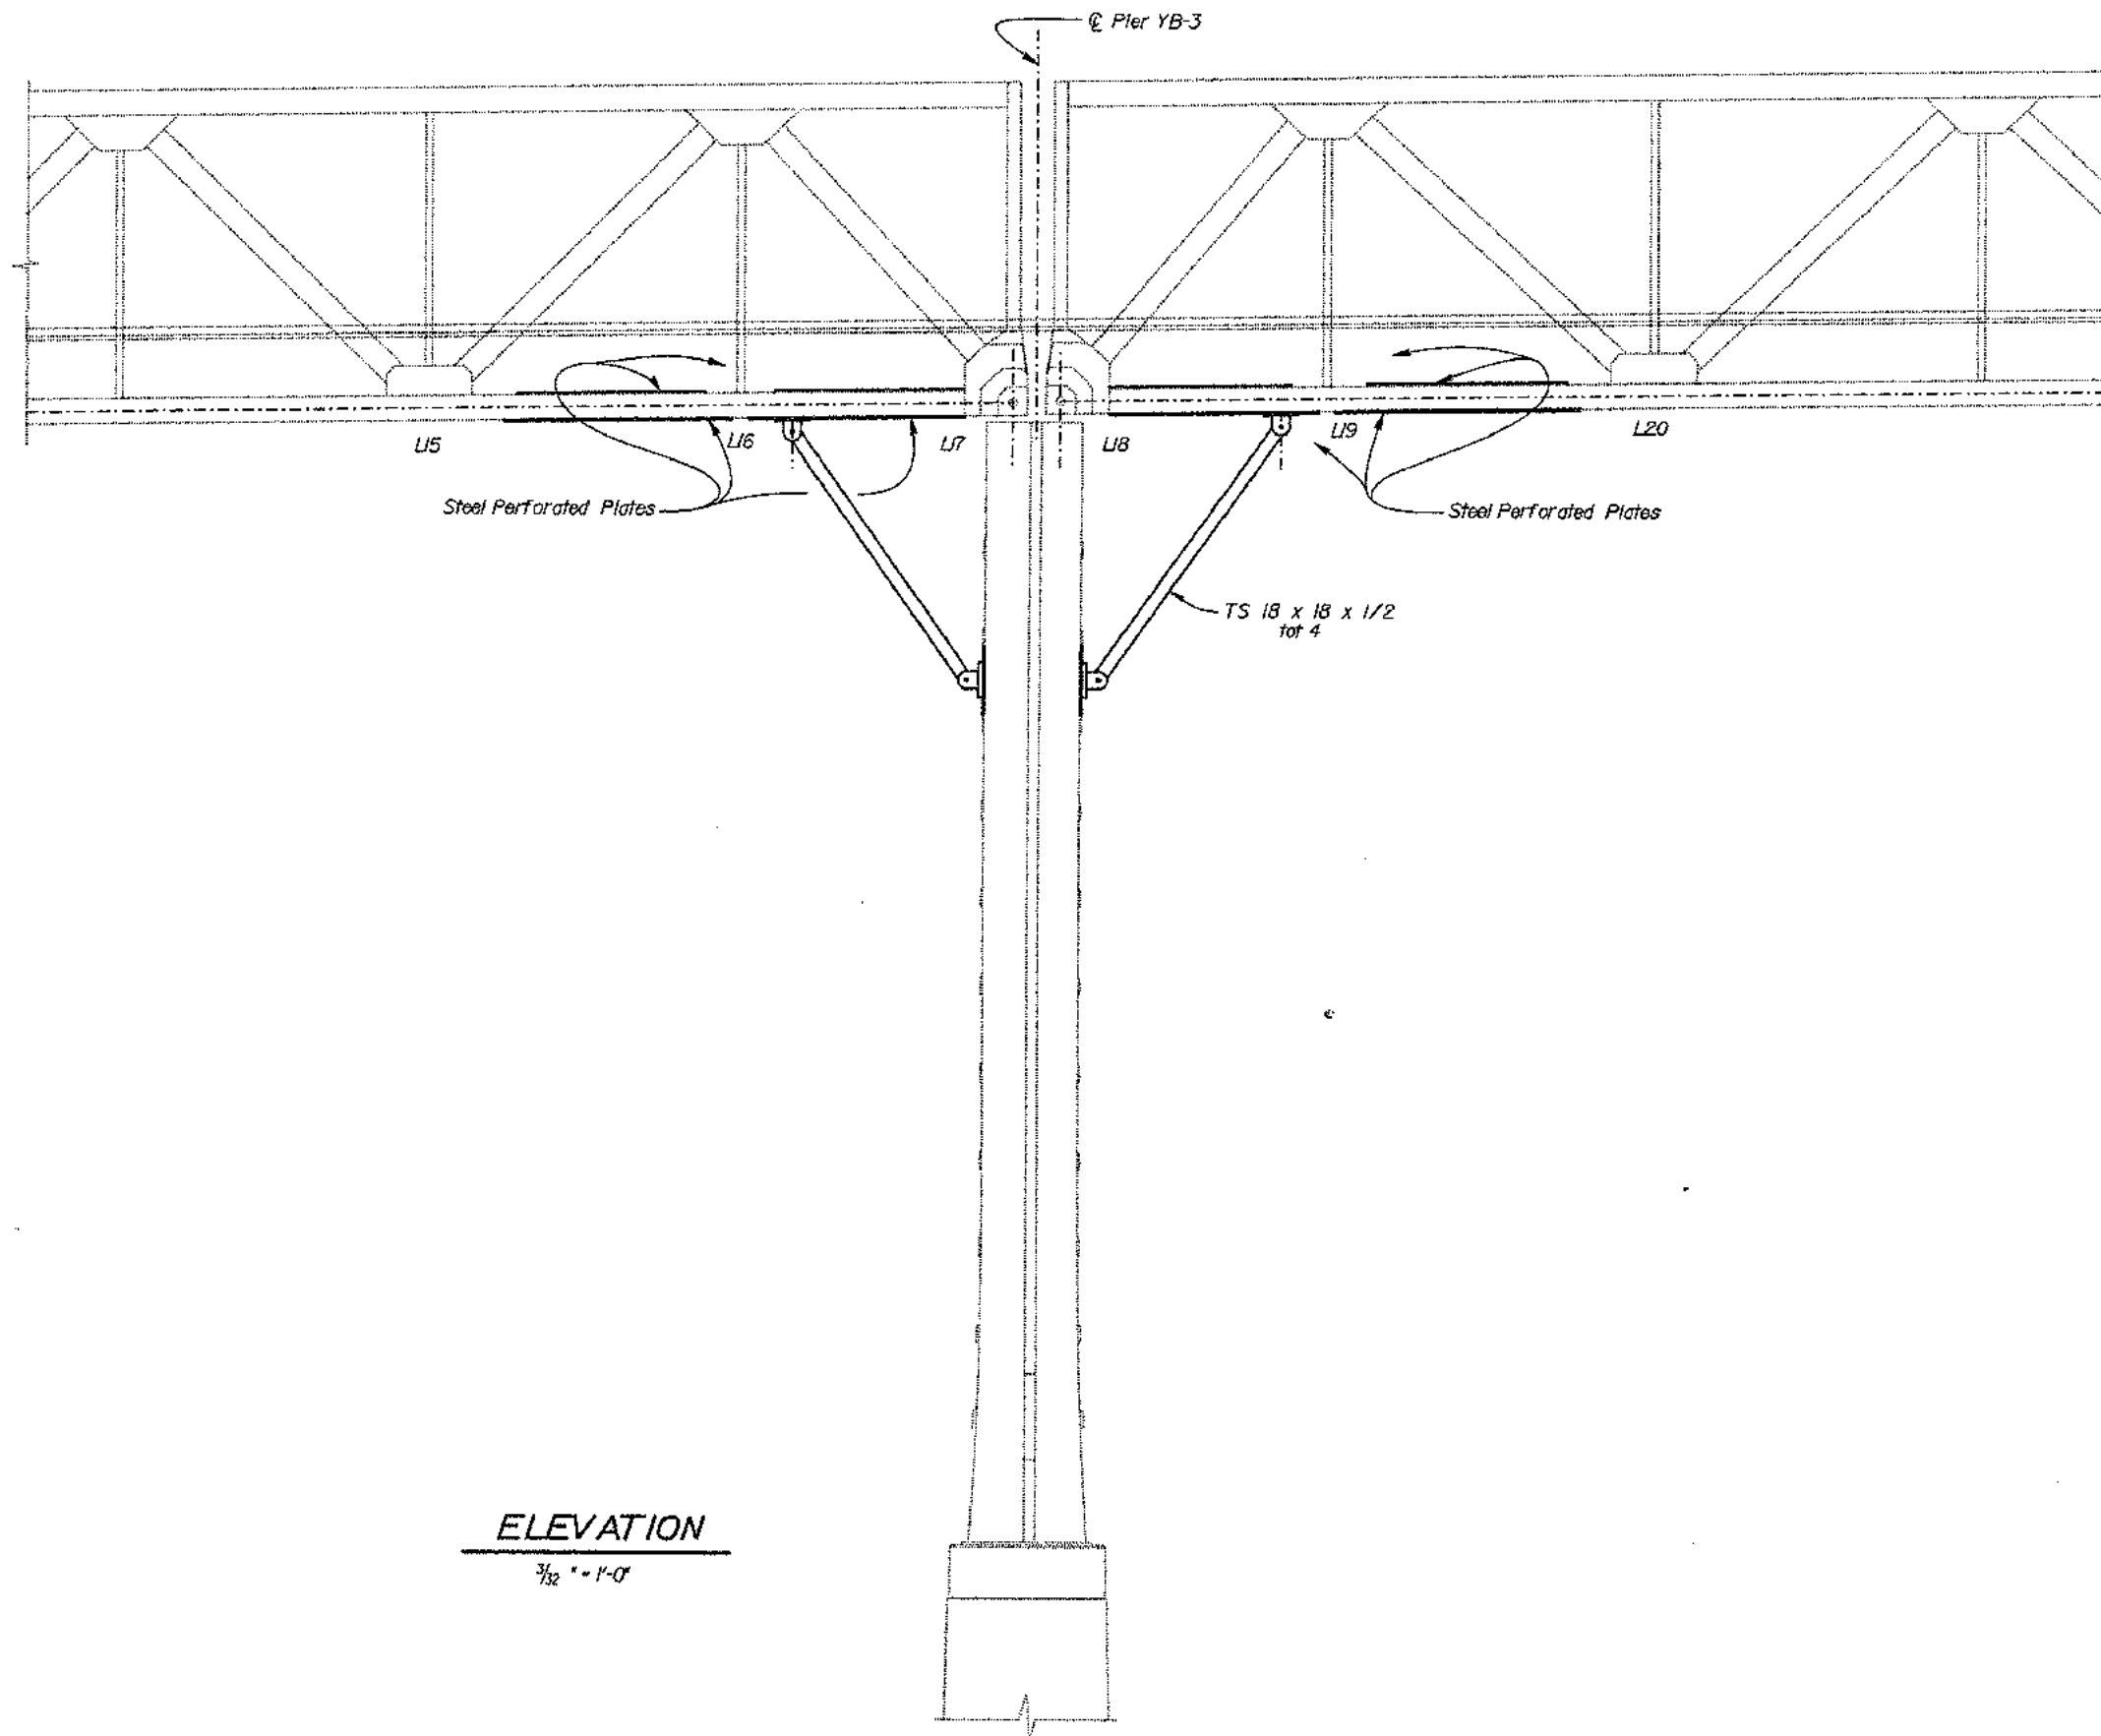

ELEVATION

1/32" = 1'-0"

DIST.	COUNTY	ROUTE	POST MILES TOTAL PROJECT	SHEET NO.	TOTAL SHEETS
04	SF, Alameda	80	7.8/8.9, 0.0/1.1	80	205

REGISTERED ENGINEER - CIVIL
October 21, 1997



12-8-97
PLANS APPROVAL DATE

The State of California or its officers or agents shall not be responsible for the accuracy or completeness of electronic copies of this plan sheet.

LEGEND

- Indicates existing structures.
- Indicates new construction.

NOTE:
THE CONTRACTOR SHALL VERIFY ALL
CONTROLLING FIELD DIMENSIONS
BEFORE ORDERING OR FABRICATING
ANY MATERIAL.

INTERIM SEISMIC RETROFIT PROJECT	
EAST BAY 288 TRUSSES YERBA BUENA ISLAND	
SAN FRANCISCO-OAKLAND BAY BRIDGE	
PIER YB-3 NO. 2	

DESIGN	BY Fadel Alameddine	CHECKED E. A. Morris
DETAILS	BY Janie Chlubna	CHECKED E. A. Morris
QUANTITIES	BY Fadel Alameddine	CHECKED E. A. Morris

STATE OF CALIFORNIA	DIVISION OF STRUCTURES
DEPARTMENT OF TRANSPORTATION	STRUCTURE DESIGN
TOLL BRIDGES SPECIAL ANALYSIS	

BRIDGE NO.	33-0025
POST MILE	1.5

DS OSD 2139 (CAD) 9/95

ORIGINAL SCALE IN INCHES
FOR REDUCED PLANS

0 1 2 3

CU 04
EA 043001

DISREGARD PRINTS BEARING
EARLIER REVISION DATES

REVISION DATES (PRELIMINARY STAGE ONLY)

1-23-97 5-2-97 5-2-97 5-2-97 5-2-97 5-2-97 5-2-97

SHEET 12 OF 36

USERNAME => trmikesl
bep1r121y2_09071059

DATE PLOTTED => 9-Dec-1997
TIME PLOTTED => 07:25

DIST.	COUNTY	ROUTE	POST MILES TOTAL PROJECT	SHEET NO.	TOTAL SHEETS
04	SF, Alameda	80	7.8/8.9, 0.0/1.1	81	205

REGISTERED ENGINEER - CIVIL
October 24, 1997


12-8-97
PLANS APPROVAL DATE

THE STATE OF CALIFORNIA OR ITS OFFICERS OR AGENTS
SHALL NOT BE RESPONSIBLE FOR THE ACCURACY OR
COMPLETENESS OF ELECTRONIC COPIES OF THIS PLAN SHEET.





NOTES:

- Place all Tie Rod Assembly Unit prior to removing any lacing on the Tower Member.
Location of Tie Rod can be field adjusted, per Engineer's approval, to clear adjacent rivets and perforation.
Work can be done simultaneously on all four Tower Members.
- Install perforated plate following installation of all Tie Rods and completion of lacing removal. Field drilling of perforated plates is permissible.

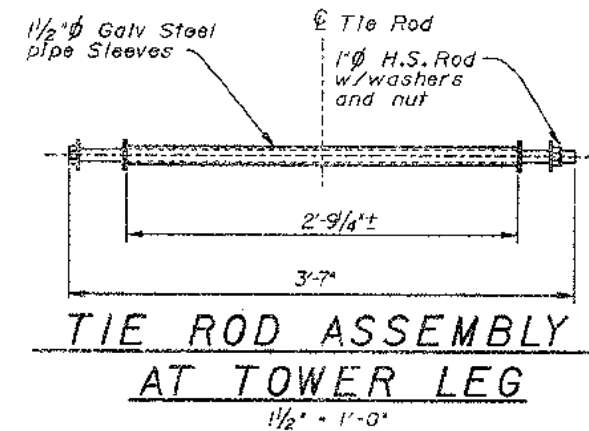


LEGEND

- Indicates existing structures.
- Indicates new construction.
- Indicates new 1" high strength bolts.
- Indicates existing 1" rivets to be removed and replaced with new 1" high strength bolts.
- Indicates approx. location of existing rivets.

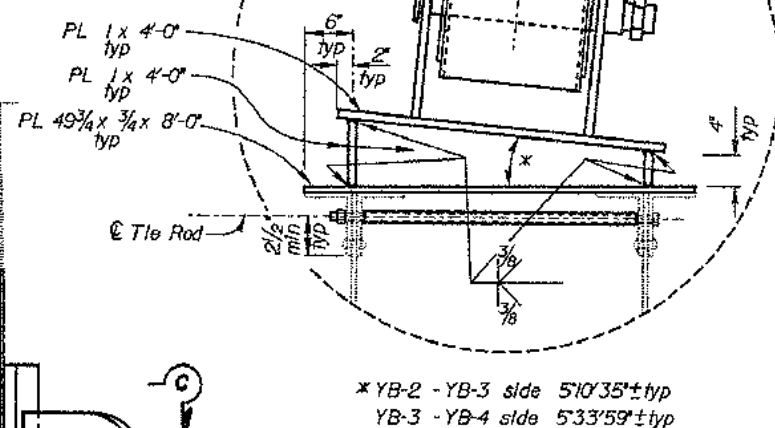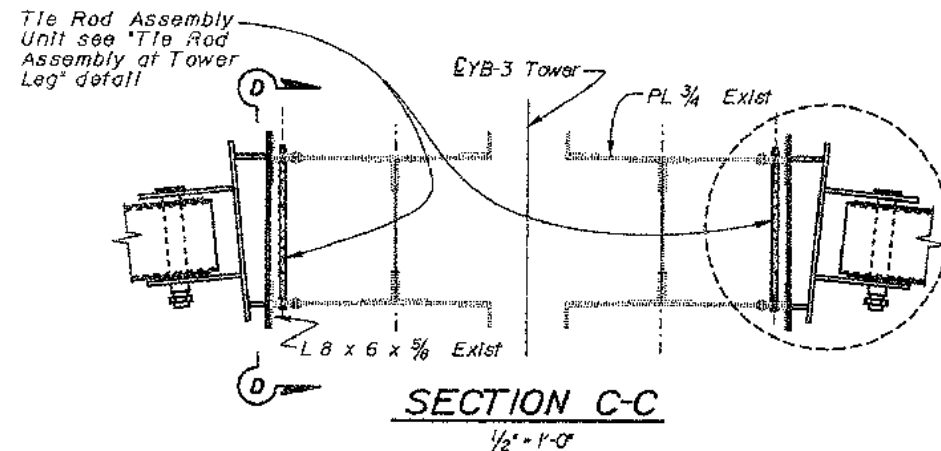


* YB-2 - YB-3 side 5'10"35"± typ
YB-3 - YB-4 side 5'33"59"± typ

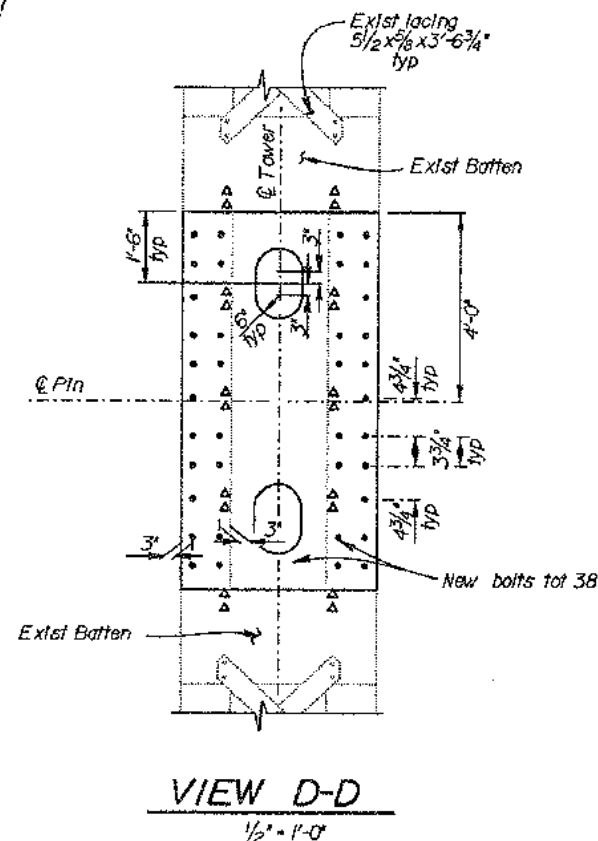

NOTE:
THE CONTRACTOR SHALL VERIFY ALL
CONTROLLING FIELD DIMENSIONS
BEFORE ORDERING OR FABRICATING
ANY MATERIAL.

NOTES:

- For details not shown
see "Base Plate Details"
sheet.
- For location of "View B-B" see
"Pier YB-3 No.1" sheet.

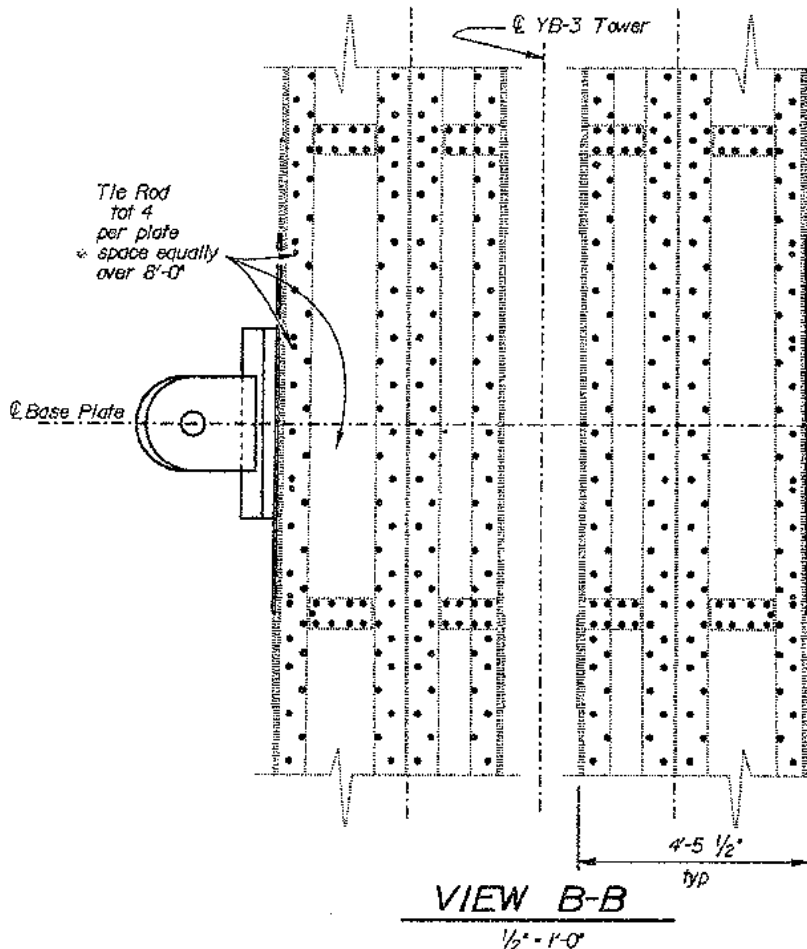

INTERIM SEISMIC RETROFIT PROJECT		
EAST BAY 288 TRUSSES YERBA BUENA ISLAND		
SAN FRANCISCO-OAKLAND BAY BRIDGE		
PIER YB-3 NO. 3		

DESIGN	BY Fadel Alameddine	CHECKED E. A. Morris
DETAILS	BY Janie Chlubna	CHECKED E. A. Morris
QUANTITIES	BY Fadel Alameddine	CHECKED E. A. Morris

STATE OF CALIFORNIA	DIVISION OF STRUCTURES
DEPARTMENT OF TRANSPORTATION	STRUCTURE DESIGN
CU 04	EA 043001

BRIDGE NO.	33-0025
POST MILE	1.5

DISREGARD PRINTS BEARING EARLIER REVISION DATES	REVISION DATES (PRELIMINARY STAGE ONLY)	SHEET 13 OF 36
--	---	----------------

NOTE:
THE CONTRACTOR SHALL VERIFY ALL
CONTROLLING FIELD DIMENSIONS
BEFORE ORDERING OR FABRICATING
ANY MATERIAL.

- NOTES:
1. For 'Section A-A' see 'Tie Rod Assembly Unit Details' sheet.
 2. For 'Base Plate' and 'Kicker' details see 'Base Plate Details' sheet.
 3. Location of Tie Rod may be field adjusted, per Engineer's approval, to clear adjacent rivets and perforation.
 4. Laces are not shown for clarity.
 5. For construction sequence see 'TIE ROD ASSEMBLY UNIT DETAILS' sheet.


LEGEND

- Indicates existing structures.
- Indicates new construction.
- Indicates new 1" ϕ high strength bolts.
- △ Indicates existing 1" ϕ rivets to be removed and replaced with new 1" ϕ high strength bolts.
- Indicates approx. location of existing rivets
- Indicates location of existing rivets where head of rivet is to be removed flush with face of the angle, rest of rivet to remain.

DIST.	COUNTY	ROUTE	POST MILES TOTAL PROJECT	SHEET NO.	TOTAL SHEETS
04	SF, Alameda	80	7.8/8.9, 0.0/1.1	82	205

REGISTERED ENGINEER - CIVIL	October 21, 1997
PLANS APPROVAL DATE	12-8-97

The State of California or its officers or agents shall not be responsible for the accuracy or completeness of electronic copies of this plan sheet.

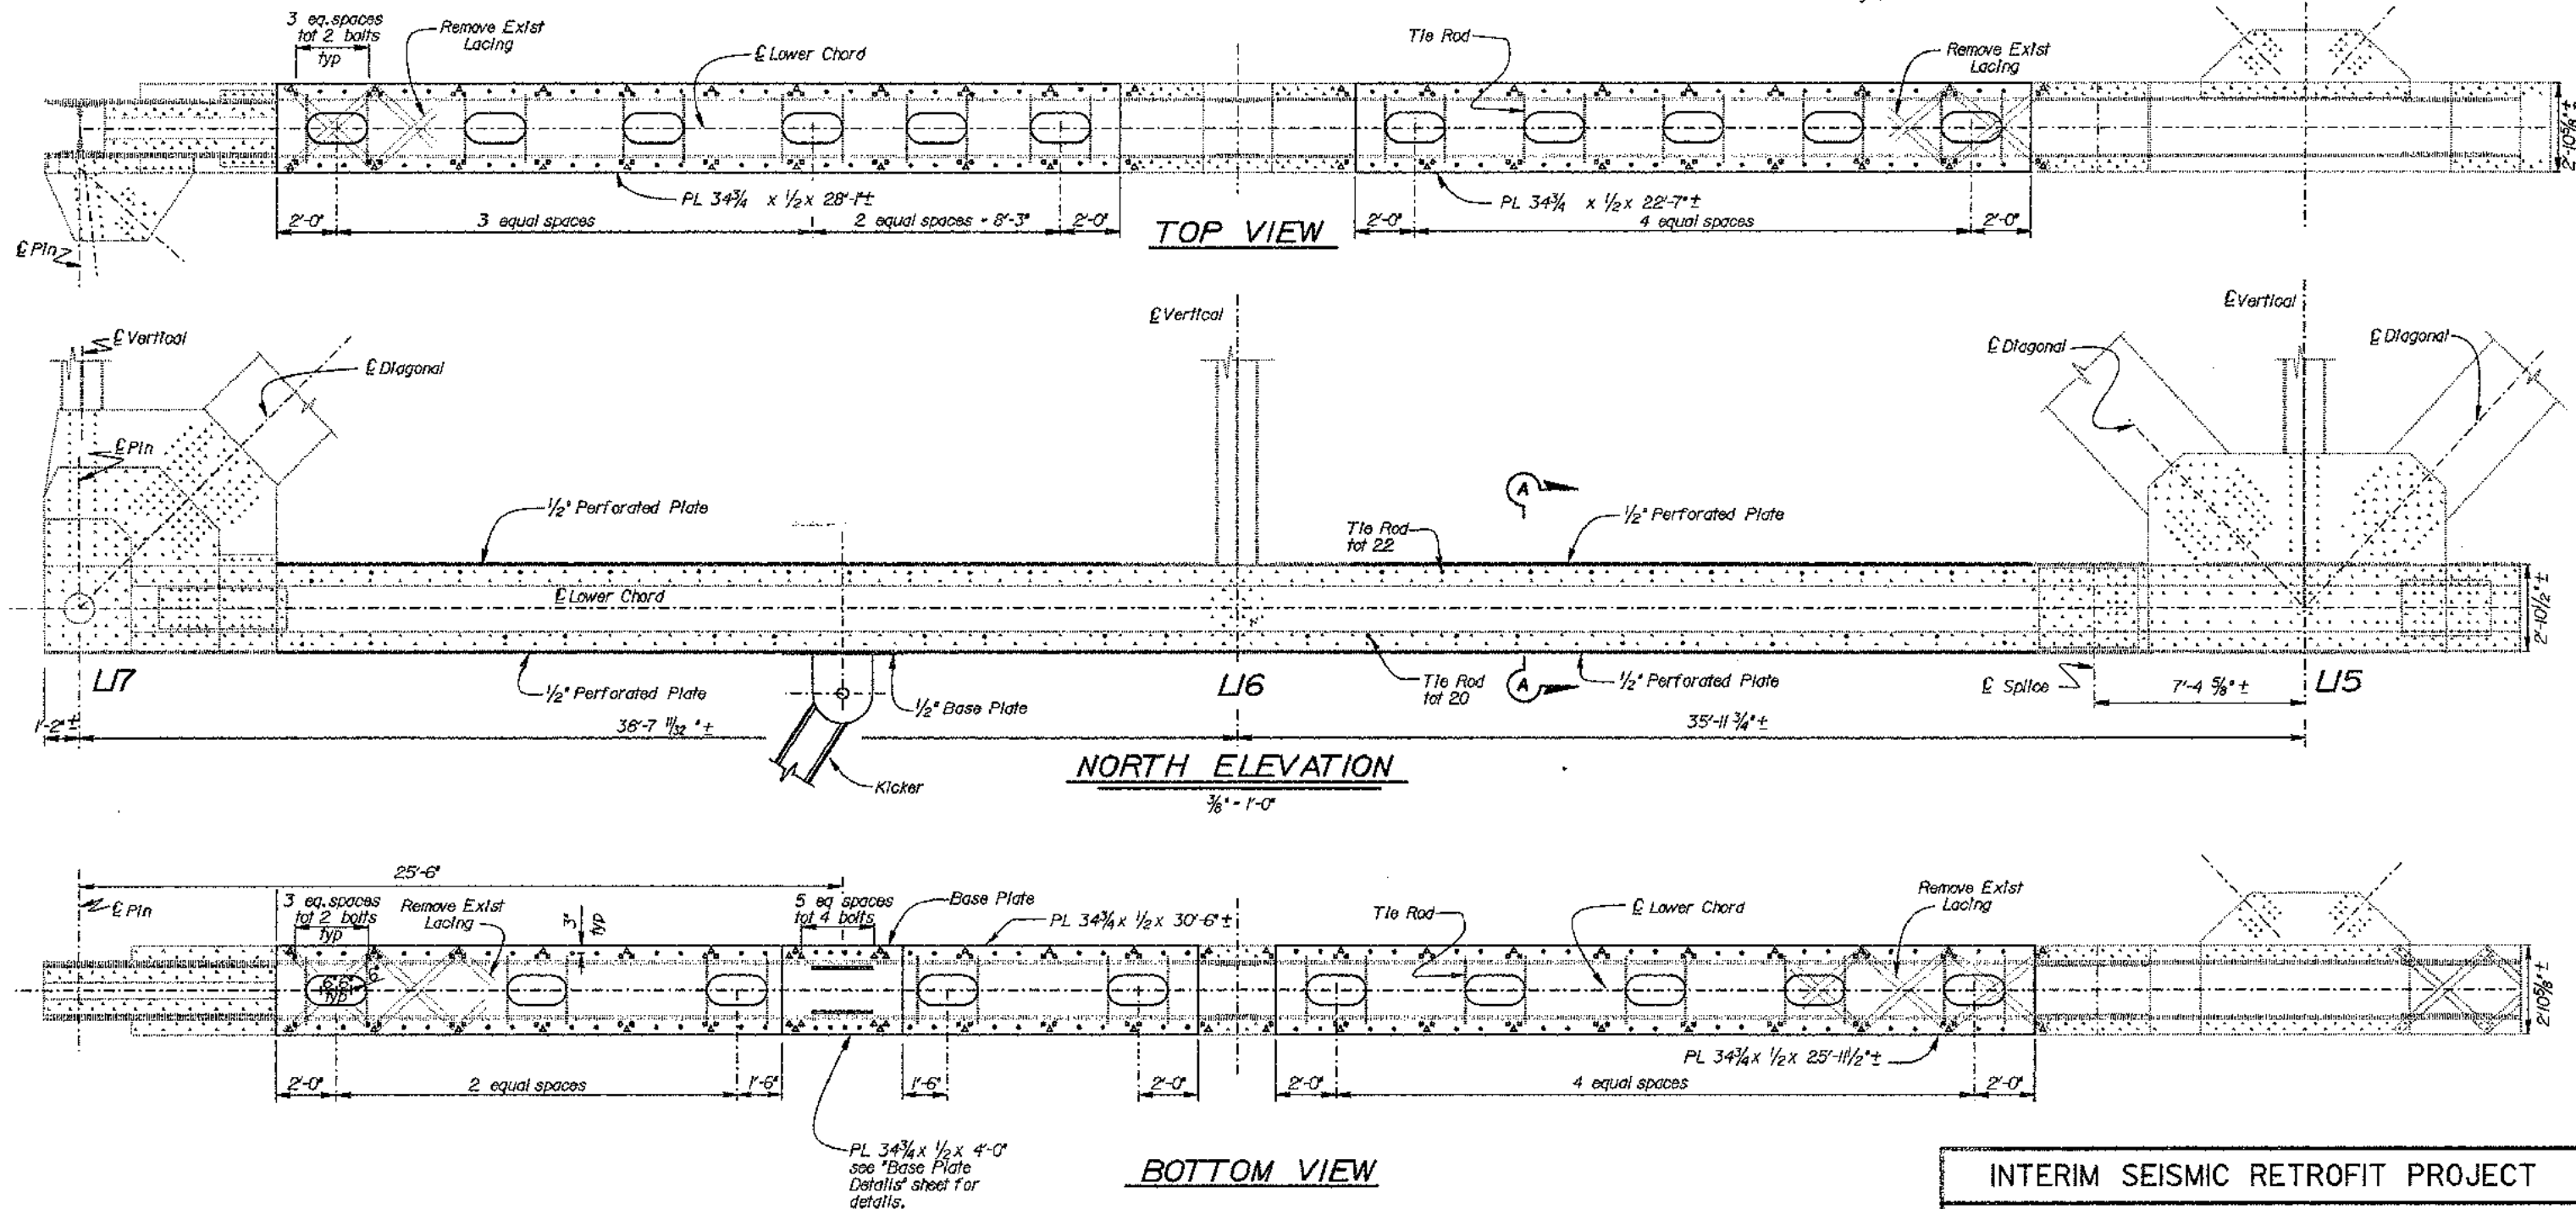

INTERIM SEISMIC RETROFIT PROJECT	
EAST BAY 288 TRUSSES YERBA BUENA ISLAND	
SAN FRANCISCO-OAKLAND BAY BRIDGE	
LOWER CHORD L15-L17	

DESIGN	BY Fadel Alameddine	CHECKED E. A. Morris
DETAILS	BY Jante Chlubna	CHECKED E. A. Morris
QUANTITIES	BY Fadel Alameddine	CHECKED E. A. Morris

STATE OF CALIFORNIA	DIVISION OF STRUCTURES
DEPARTMENT OF TRANSPORTATION	STRUCTURE DESIGN
	TOLL BRIDGES SPECIAL ANALYSIS

BRIDGE NO.	33-0025
POST MILE	1.5

DATE PLOTTED	9-10-97	TIME PLOTTED	07:28
DATE PLOTTED	9-10-97	TIME PLOTTED	07:28

OS QSD 859 (CADD 9/95)	ORIGINAL SCALE IN INCHES FOR REDUCED PLANS	CU 04 EA 043001	USERNAME: trmkies	DATE: 9/10/97	SHEET 14 OF 36
------------------------	--	-----------------	-------------------	---------------	----------------

NOTES:

For 'Section A-A' see 'Tie Rod Assembly Unit Details' sheet.

For 'Base Plate' and 'Kicker' details see 'Base Plate Details' sheet.

Location of Tie Rod may be field adjusted, per Engineer's approval, to clear adjacent rivets and perforation.

Laces are not shown for clarity.

For typical perforation dimensions see 'Lower Chord L15-L17' sheet.

For construction sequence see 'TIE ROD ASSEMBLY UNIT DETAILS' sheet.

LEGEND

Indicates existing structures.

Indicates new construction.

Indicates new 1" ϕ high strength bolts.

Indicates existing 1" ϕ rivets to be removed and replaced with new 1" ϕ high strength bolts.

Indicates approx. location of existing rivets


Indicates location of existing rivets where head of rivet is to be removed flush with face of the angle, rest of rivet to remain.

DIST.	COUNTY	ROUTE	POST MILES TOTAL PROJECT	SHEET NO.	TOTAL SHEETS
04	SF, Alameda	80	7.8/8.9, 0.0/1.1	83	205

REGISTERED ENGINEER - CIVIL
October 21, 1997

12-8-97
PLANS APPROVAL DATE

THE STATE OF CALIFORNIA OR ITS OFFICERS OR AGENTS SHALL NOT BE RESPONSIBLE FOR THE ACCURACY OR COMPLETENESS OF ELECTRONIC COPIES OF THIS PLAN SHEET.

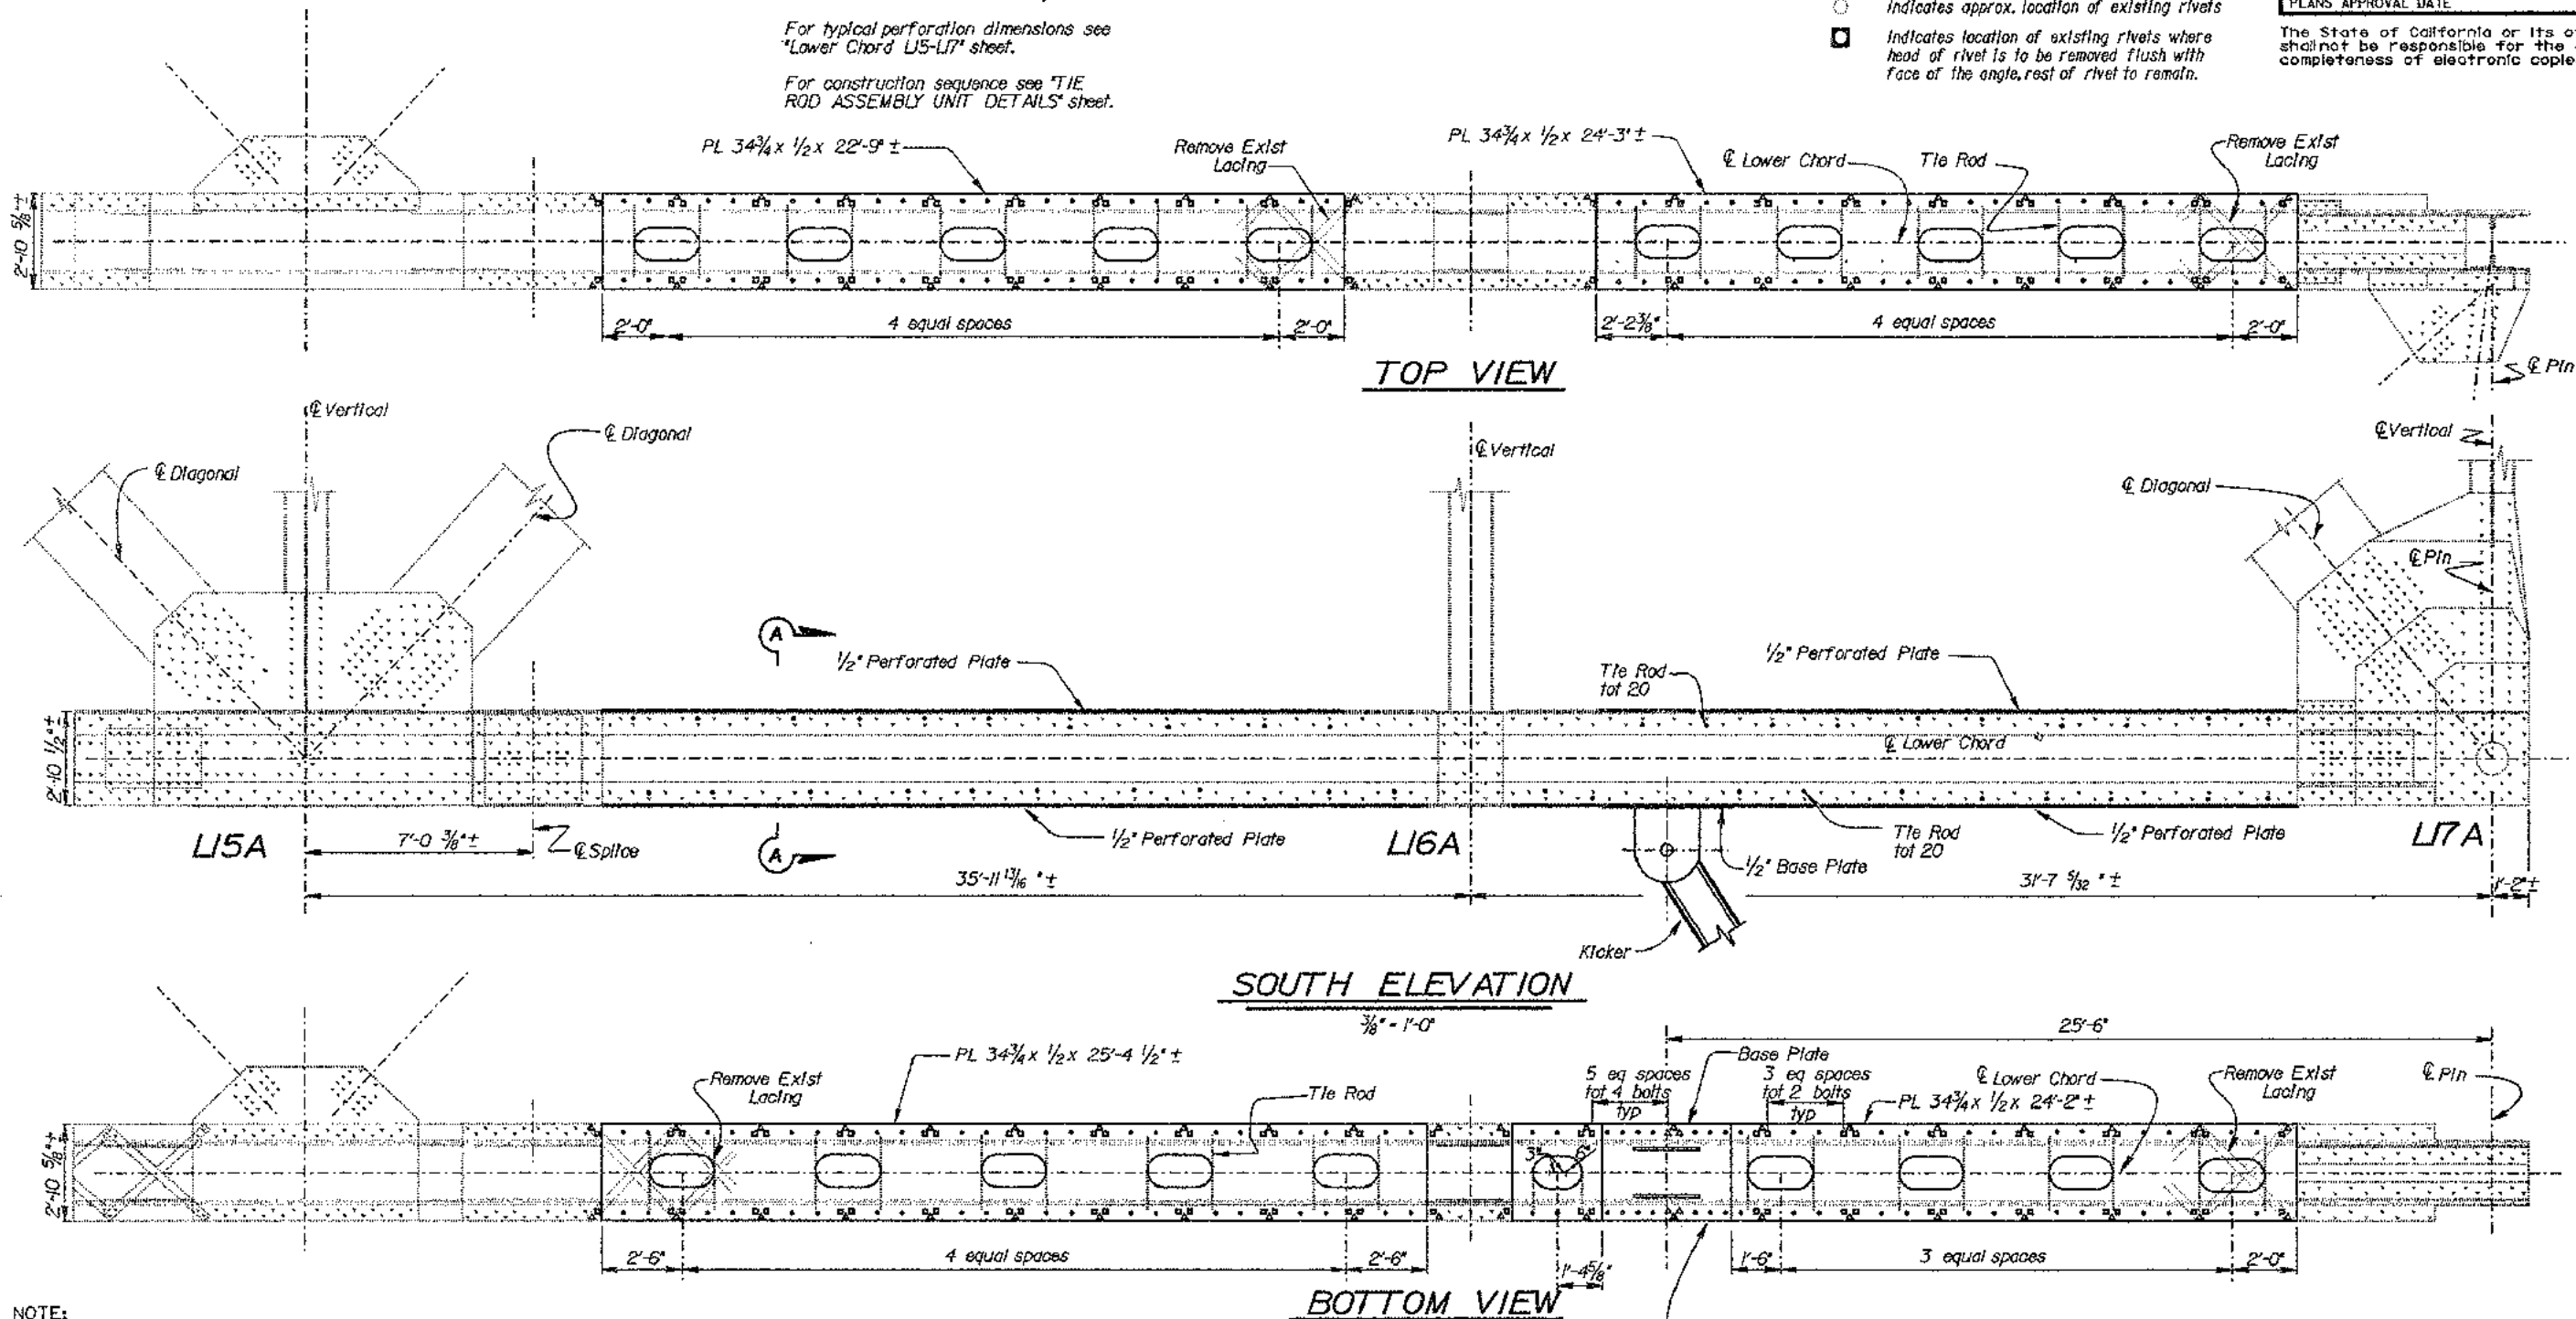

NOTE:
THE CONTRACTOR SHALL VERIFY ALL CONTROLLING FIELD DIMENSIONS BEFORE ORDERING OR FABRICATING ANY MATERIAL.

INTERIM SEISMIC RETROFIT PROJECT	
EAST BAY 288 TRUSSES YERBA BUENA ISLAND	
SAN FRANCISCO-OAKLAND BAY BRIDGE	
LOWER CHORD L15A-L17A	
BRIDGE NO. 33-0025	POST MILE 1.5
DISCARD PRINTS BEARING EARLIER REVISION DATES	
REVISION DATES (PRELIMINARY STAGE ONLY)	
15	36

DESIGN	BY Fadel Alameddine	CHECKED E. A. Morris
DETAILS	BY Janie Chlubna	CHECKED E. A. Morris
QUANTITIES	BY Fadel Alameddine	CHECKED E. A. Morris

STATE OF CALIFORNIA	DIVISION OF STRUCTURES
DEPARTMENT OF TRANSPORTATION	STRUCTURE DESIGN
	TOLL BRIDGES SPECIAL ANALYSIS

CU 04
EA 043001

USERNAME => trm1k0st
sepr15dt2.09071224

NOTE:
THE CONTRACTOR SHALL VERIFY ALL
CONTROLLING FIELD DIMENSIONS
BEFORE ORDERING OR FABRICATING
ANY MATERIAL.

NOTES:

For 'Section A-A' see 'Tie Rod
Assembly Unit Details' sheet.

For 'Base Plate' and 'Kicker' details
see 'Base Plate Details' sheet.

Location of Tie Rod may be field adjusted,
per Engineer's approval, to clear adjacent
rivets and perforation.

Laces are not shown for clarity.

For typical perforation dimensions see
'Lower Chord L15-L17' sheet.

For construction sequence see 'TIE ROD
ASSEMBLY UNIT DETAILS' sheet.

LEGEND

Indicates existing structures.

Indicates new construction.

Indicates new 1" ϕ high strength bolts.

Indicates existing 1" ϕ rivets to be removed and
replaced with new 1" ϕ high strength bolts.

Indicates approx. location of existing rivets.


Indicates location of existing rivets where
head of rivet is to be removed flush with
face of the angle, rest of rivet to remain.

DIST.	COUNTY	ROUTE	POST MILES TOTAL PROJECT	SHEET NO.	TOTAL SHEETS
04	SF, Alameda	80	7.8/8.9, 0.0/1.1	84	205

REGISTERED ENGINEER - CIVIL
October 21, 1997

12-8-97
PLANS APPROVAL DATE

THE STATE OF CALIFORNIA OR ITS OFFICERS OR AGENTS
SHALL NOT BE RESPONSIBLE FOR THE ACCURACY OR
COMPLETENESS OF ELECTRONIC COPIES OF THIS PLAN SHEET.

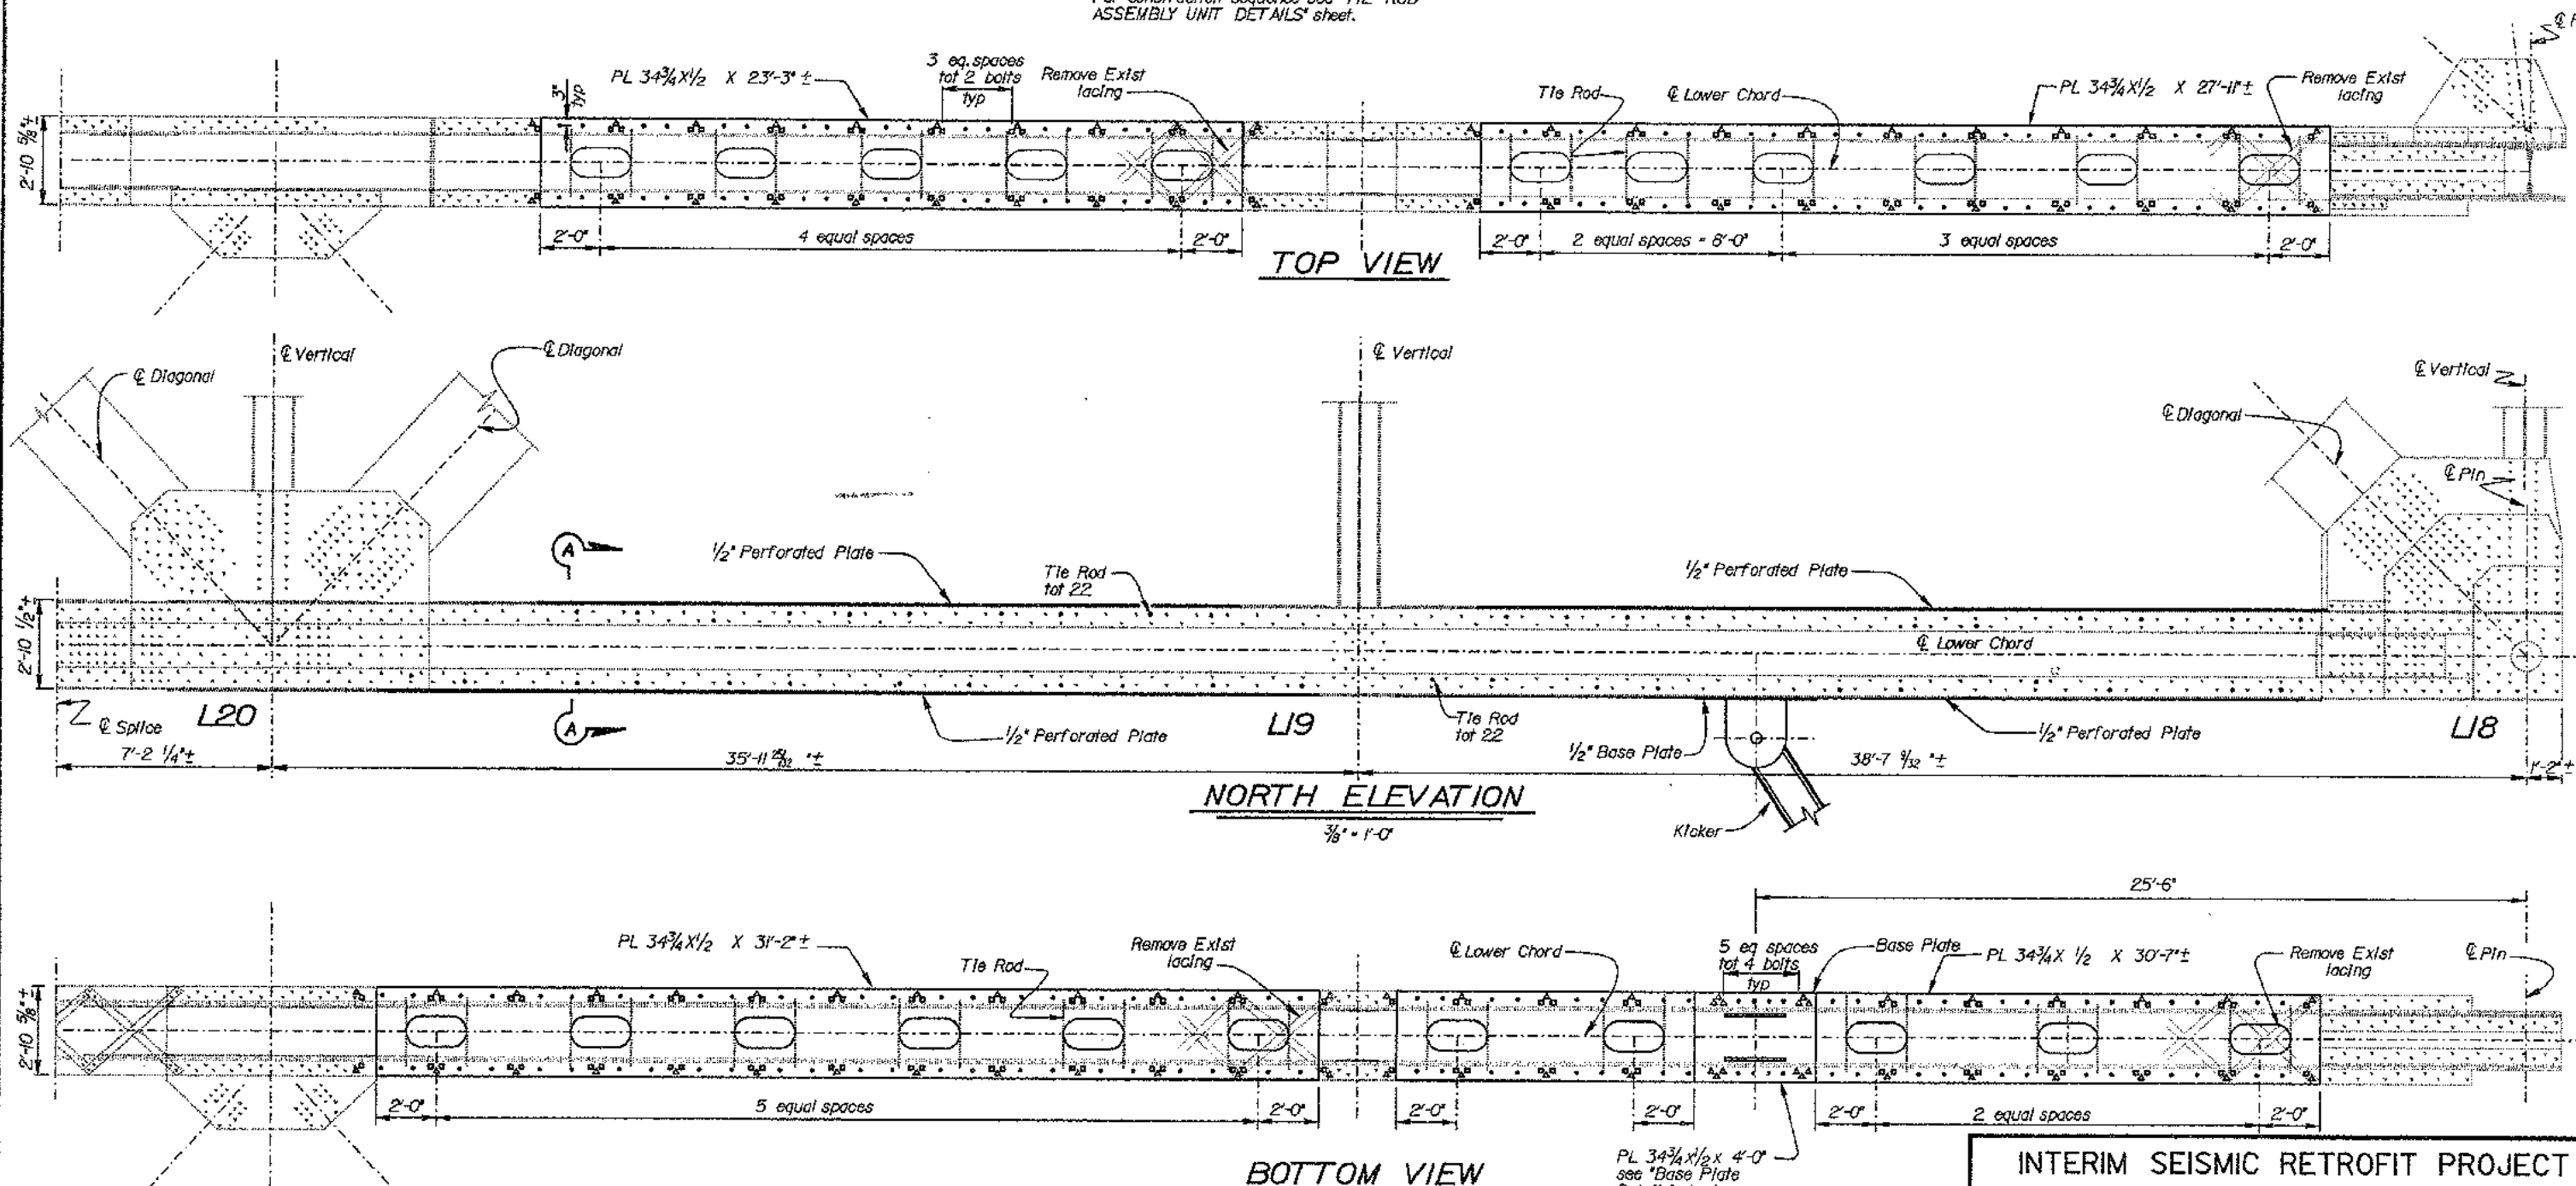

DESIGN	BY Fadel Alameddine	CHECKED E. A. Morris
DETAILS	BY Janie Chlubna	CHECKED E. A. Morris
QUANTITIES	BY Fadel Alameddine	CHECKED E. A. Morris

STATE OF CALIFORNIA DEPARTMENT OF TRANSPORTATION	DIVISION OF STRUCTURES STRUCTURE DESIGN TOLL BRIDGES SPECIAL ANALYSIS
---	--

BRIDGE NO. 33-0025	POST MILE 1.5
-----------------------	------------------

INTERIM SEISMIC RETROFIT PROJECT
EAST BAY 288 TRUSSES YERBA BUENA ISLAND
SAN FRANCISCO-OAKLAND BAY BRIDGE
LOWER CHORD L18-L20

DS OSD 215 (CADD) 9/95	ORIGINAL SCALE IN INCHES FOR REDUCED PLANS	0 1 2 3	CU 04 EA 043001	DISREGARD PRINTS BEARING EARLIER REVISION DATES	REVISION DATES (PRELIMINARY STAGE ONLY)	SHEET 16 OF 36
------------------------	---	---------	--------------------	--	---	----------------

NOTES:

Existing painter's platform vertical legs (attached to top of lower chord L18A-L20A) not shown, shall be temporarily detached, supported and reinstalled as per Engineer's approval.

Existing pipe hangers (attached to bottom of lower chord L18A-L20A) not shown, shall be temporarily detached, supported and reinstalled as per Engineer's approval.

NOTES:

For 'Section A-A' see 'Tie Rod Assembly Unit Details' sheet.

For 'Base Plate' and 'Kicker' details see 'Base Plate Details' sheet.

Location of Tie Rod may be field adjusted, per Engineer's approval, to clear adjacent rivets and perforation.

Laces are not shown for clarity.

For typical perforation dimensions see 'Lower Chord L15-L17' sheet.

For construction sequence see 'TIE ROD ASSEMBLY UNIT DETAILS' sheet.

LEGEND


- Indicates existing structures.
- Indicates new construction.
- Indicates new 1" ϕ high strength bolts.
- △ Indicates existing 1" ϕ rivets to be removed and replaced with new 1" ϕ high strength bolts.
- Indicates approx. location of existing rivets.
- Indicates location of existing rivets where head of rivet is to be removed flush with face of the angle, rest of rivet to remain.

DIST.	COUNTY	ROUTE	POST MILES TOTAL PROJECT	SHEET NO.	TOTAL SHEETS
04	SF, Alameda	80	7.8/8.9 0.0/1.1	85	205

REGISTERED ENGINEER - CIVIL
October 21, 1997

12-8-97
PLANS APPROVAL DATE

The State of California or its officers or agents shall not be responsible for the accuracy or completeness of electronic copies of this plan sheet.

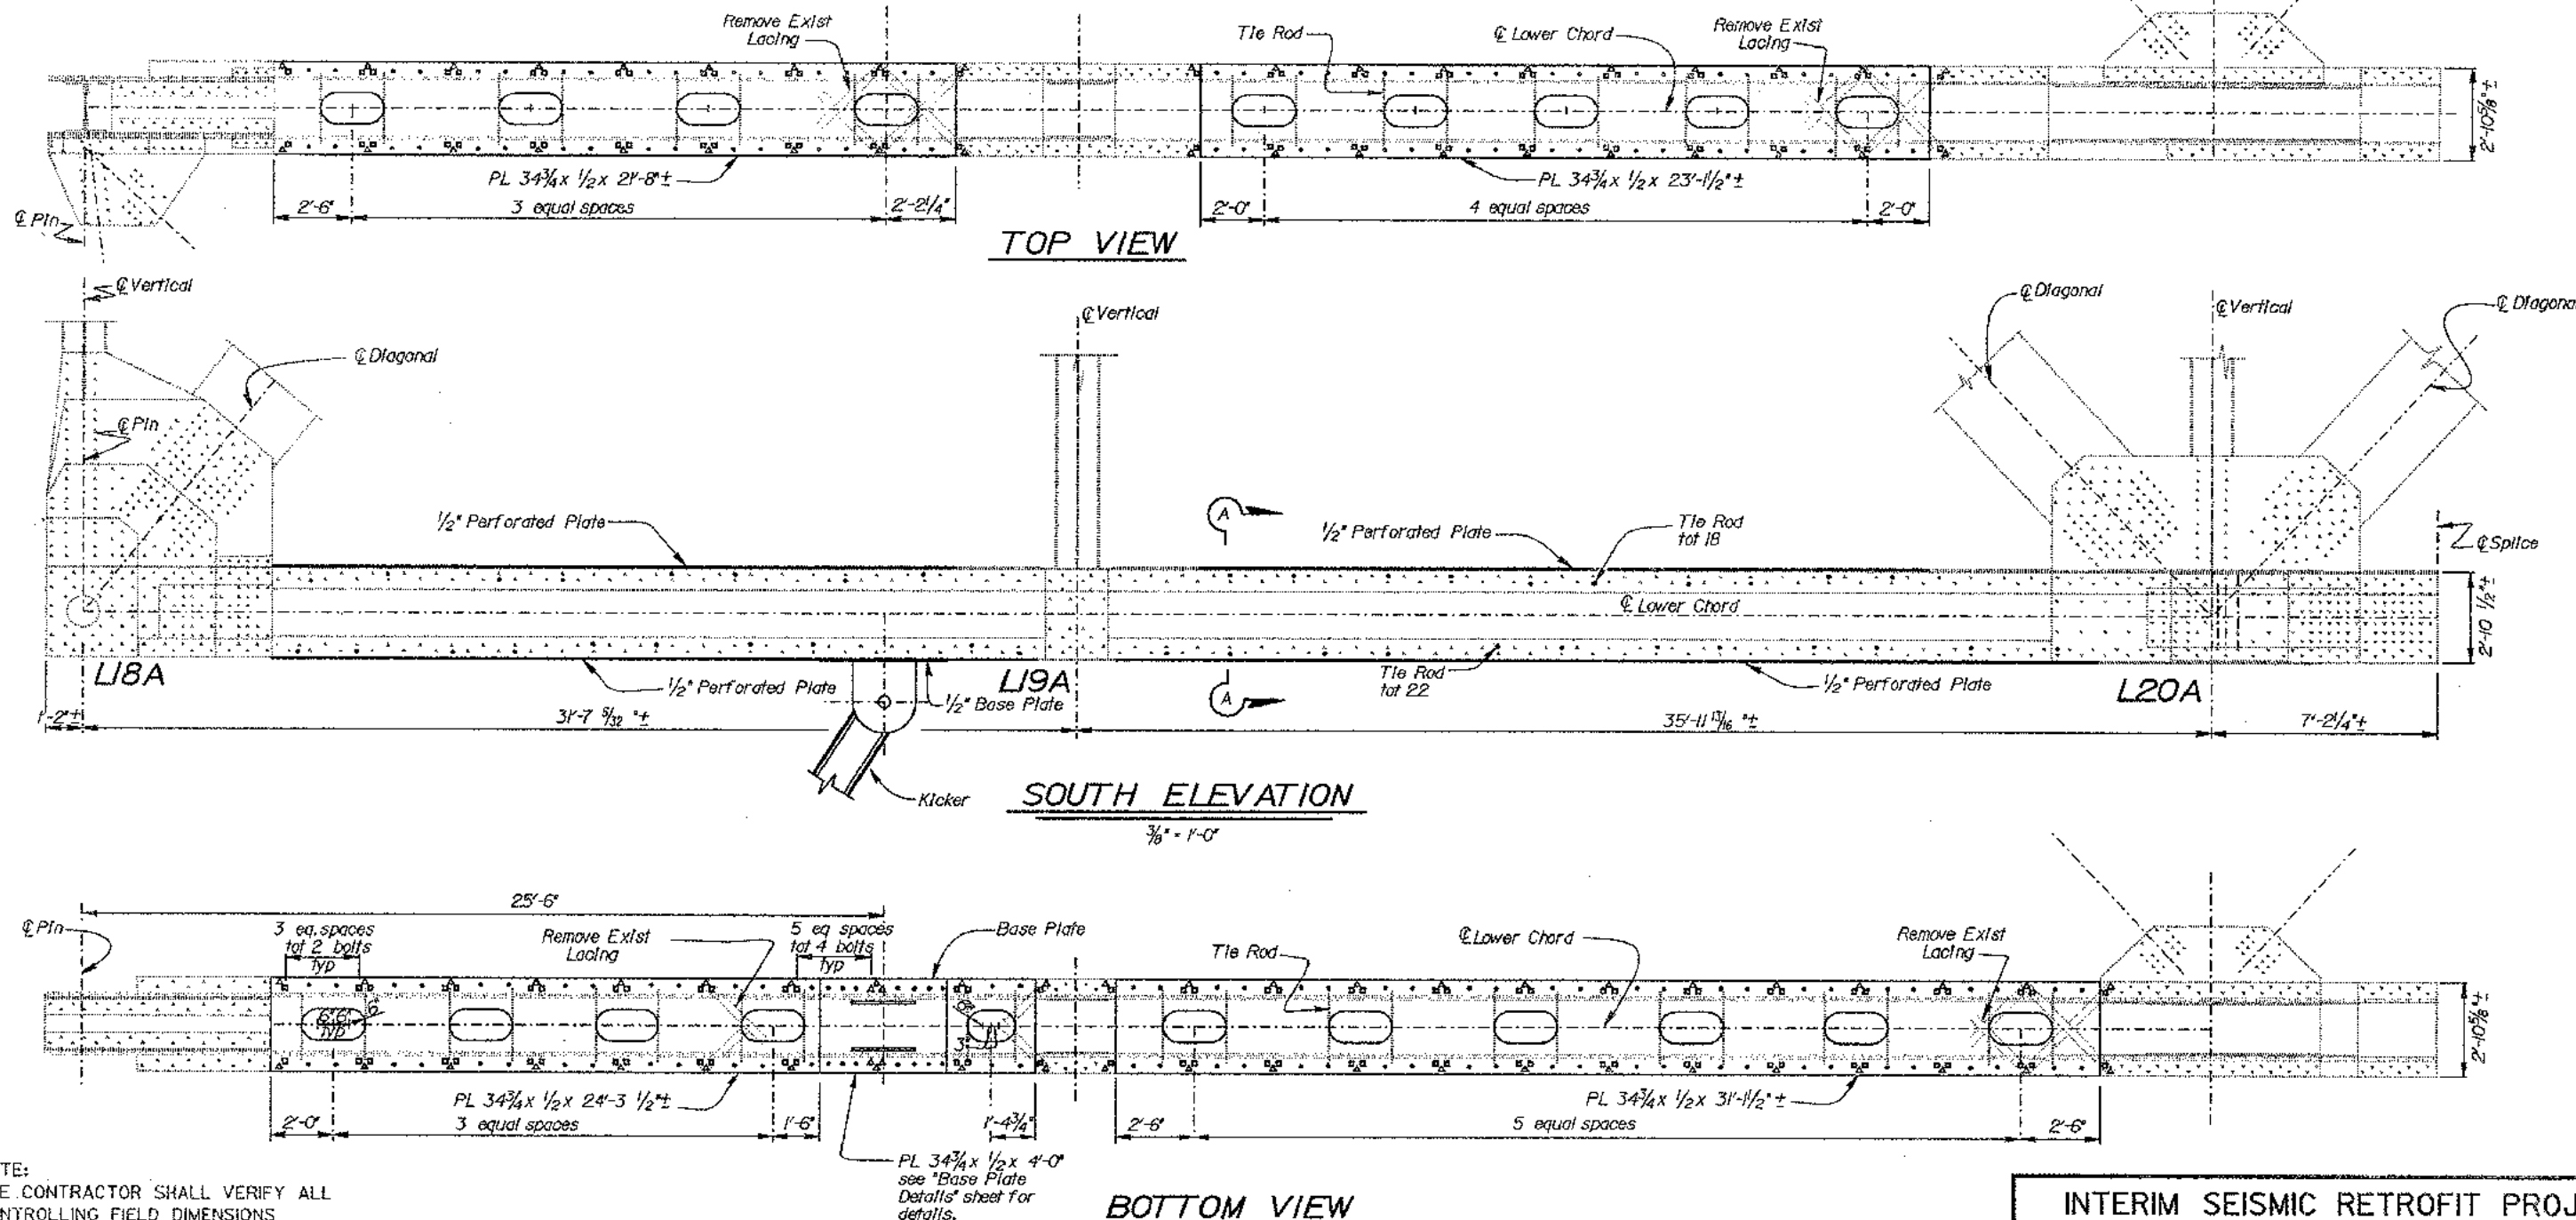

NOTE:
THE CONTRACTOR SHALL VERIFY ALL CONTROLLING FIELD DIMENSIONS BEFORE ORDERING OR FABRICATING ANY MATERIAL.


DESIGN	BY Fadel Alameddine	CHECKED E. A. Morris
DETAILS	BY Jante Chlubna	CHECKED E. A. Morris
QUANTITIES	BY Fadel Alameddine	CHECKED E. A. Morris


STATE OF CALIFORNIA	DIVISION OF STRUCTURES
DEPARTMENT OF TRANSPORTATION	STRUCTURE DESIGN
CLL 04	EA 043001

BRIDGE NO.	33-0025
POST MILE	1.5

INTERIM SEISMIC RETROFIT PROJECT
EAST BAY 288 TRUSSES YERBA BUENA ISLAND
SAN FRANCISCO-OAKLAND BAY BRIDGE
LOWER CHORD L18A-L20A

DIST.	COUNTY	ROUTE	POST MILES TOTAL PROJECT	SHEET NO.	TOTAL SHEETS
04	SF. Alameda	80	7.8/8.9 0.0/1.1	87	205

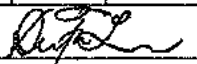
REGISTERED ENGINEER - CIVIL
October 21, 1997



No. 50078
Exp. 9-30-01
CIVIL
STATE OF CALIFORNIA

12-8-97
PLANS APPROVAL DATE

The State of California or its officers or agents shall not be responsible for the accuracy or completeness of electronic copies of this plan sheet.


LEGEND

- Indicates existing structures.
- Indicates new construction.

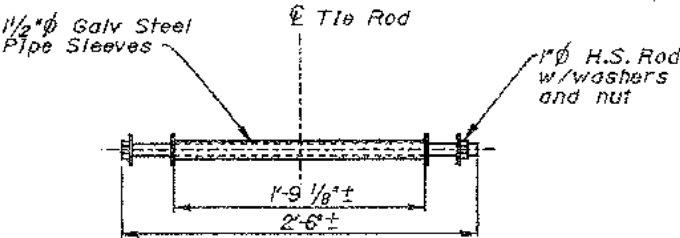

TIE ROD ASSEMBLY
AT LOWER CHORD

1 1/2" = 1'-0"

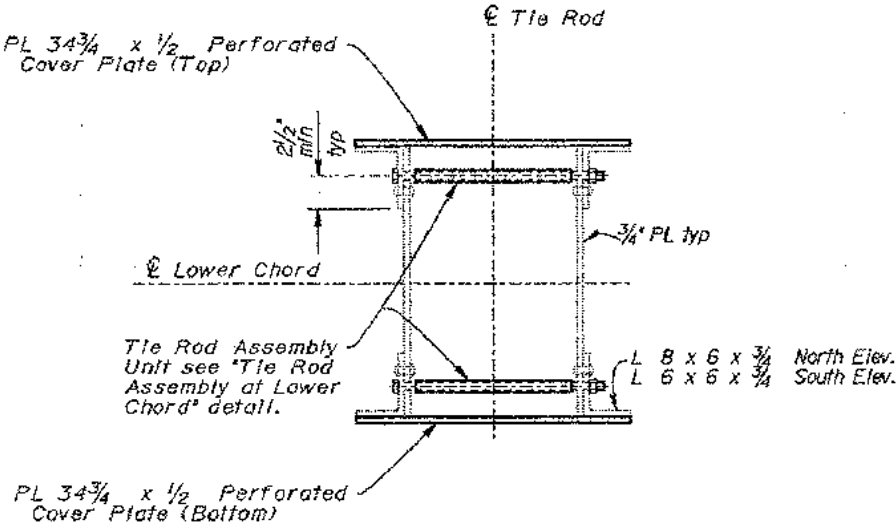

SECTION A-A

1" = 1'-0"

For location of 'Section A-A' see
'Lower Chord U15-U17',
'Lower Chord U3A-U7A',
'Lower Chord U8-L20' and
'Lower Chord U8A-L20A' sheets.

Construction Sequence for Bottom Chord Retrofit:

- Place all Tie Rod Assembly Units prior to removing any ice on the Lower Chord.

Work may be done simultaneously on all four lower chords.
- Install bottom perforated plate following installation of all Tie Rods and completion of bottom ice removal. Field drilling of perforated plates is permissible.
- Install top perforated plate.

NOTE:
THE CONTRACTOR SHALL VERIFY ALL
CONTROLLING FIELD DIMENSIONS
BEFORE ORDERING OR FABRICATING
ANY MATERIAL.

INTERIM SEISMIC RETROFIT PROJECT	
EAST BAY 288 TRUSSES YERBA BUENA ISLAND	
SAN FRANCISCO-OAKLAND BAY BRIDGE	
TIE ROD ASSEMBLY UNIT DETAILS	

DESIGN	BY Fadel Alameddine	CHECKED E. A. Morris
DETAILS	BY Janie Chlubna	CHECKED E. A. Morris
QUANTITIES	BY Fadel Alameddine	CHECKED E. A. Morris

STATE OF CALIFORNIA
DEPARTMENT OF TRANSPORTATION

DIVISION OF STRUCTURES
STRUCTURE DESIGN
TOLL BRIDGES SPECIAL ANALYSIS

BRIDGE NO.	33-0025
POST MILE	1.5
REVISION DATES (PRELIMINARY STAGE ONLY)	
DATE PLOTTED 12-8-97	
SHEET	19
OF	36

SEQUENCE FOR RETROFIT OF VERTICAL MEMBERS

1. Remove ladders, brackets, railings, platforms and other items attached to the vertical if they will interfere with the retrofit work. Provide temporary supports for utilities where necessary.
2. Drill all new 1/4" diameter holes on the inside flanges of the vertical.
3. Remove all rivets in Fastener Group "A" and the upper six rivets in Fastener Group "C". Replace rivets with 1" diameter A325 H.S. Bolts.
4. Remove all rivets in Fastener Group "B" and the upper six rivets in Fastener Group "D". Replace rivets with 1" diameter A325 H.S. Bolts.
5. Remove the lower nine rivets in Fastener Group "D" and the lower nine rivets in Fastener Group "C". Replace rivets with 1" diameter A325 H.S. Bolts, (except in L0-U0, L0-U0A, L8-U8, and L8-U8A which have ten rivets)
6. Remove all rivets in Fastener Groups "E1", "E2" and "E3". Remove existing floor beam bracket.
7. Remove all rivets in Fastener Group "F".
8. Remove all rivets in Fastener Groups "H1" and "H2". Remove inside existing filler plate between vertical and lower floor beam.
9. Place inside cover plate VCP1, filler plate VFP1, angle VAIW, insert and tighten 1" diameter A325 H.S. Bolt Fastener Groups "F", "H1" and "KIW".
10. Remove all rivets in Fastener Group "G".
11. Place angle VAIW, insert and tighten 1" diameter A325 H.S. Bolt Fastener Groups "G", "H2" and "KIE".
12. Place floor beam bracket assembly, insert and tighten 1" diameter H.S. Bolt Fastener Groups "E1", "E2" and "E3".
13. Drill all new 1/4" diameter holes on the outside flanges of the vertical.
14. Remove all rivets in Fastener Groups "I1".
15. Place splice plates VSP1W and VSP2W, insert and tighten 1" diameter A325 H.S. Bolt Fastener Group "I1".
16. Remove all rivets in Fastener Groups "J1".
17. Place splice VSP1E and VSP2E, insert and tighten 1" diameter A325 H.S. Bolt Fastener Group "J1".
18. Place outside cover plate VCP2, filler plate VFP2, angle VA2W and VA2E, insert and tighten 1" diameter A325 H.S. Bolt Fastener Groups "I2", "J2", "K2E", and "K2W".
19. Weld all stiffener plates to angle pairs VAIW/VAIE and VA2W/VA2E with 1/4" fillet weld.
20. Place perforated plates VPCPW and VPCPE, insert and tighten 1" diameter A325 H.S. Bolts along entire length of both plates.
21. Replace all utilities on new cover plates by making adjustments as required and as approved by the Engineer.

ANNOTATION


VAIE	Vertical Angle, Deck side and East side
VAIW	Vertical Angle, Deck side and West side
VA2E	Vertical Angle, Outside and East side
VA2W	Vertical Angle, Outside and West side
VCP1	Vertical Cover Plate, Deck side
VCP2	Vertical Cover Plate, Outside
VFP1	Vertical Filler Plate, Deck side
VFP2	Vertical Filler Plate, Outside
VSP1E	Vertical Splice Plate, Inside of VSP2E
VSP1W	Vertical Splice Plate, Inside of VSP2W
VSP2E	Vertical Splice Plate, Outside, East half
VSP2W	Vertical Splice Plate, Outside, West half
VPCPE	Vertical Perforated Cover Plate East side
VPCPW	Vertical Perforated Cover Plate West side

Notes:

1. For Fastener Group (F.G.) Identifies, see "Miscellaneous Details No. 4" sheet.
2. If conflict arises in the local sequence stated above, the Contractor shall submit an explanation and a proposed alternative to the Engineer, in writing, for approval prior to altering the sequence.

GLOBAL SEQUENCE FOR RETROFIT OF VERTICAL MEMBERS

1. Work may be performed on both vertical members simultaneously on one side of each 288 ft truss. Work may be performed on all trusses simultaneously.
2. Work may not proceed on the North and South sides simultaneously. Before work activities begin on the second side, all work on the first side must be completed. For the work to be considered complete, the 21-step sequence must be completed on both vertical members on the same side of the truss.
3. Before a construction recess longer than 6 hours, all existing rivets that have been removed must be replaced with new bolts, and all new holes must be plugged with new bolts.

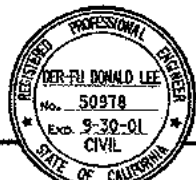DIST.	COUNTY	ROUTE	POST MILES TOTAL PROJECT	SHEET NO.	TOTAL SHEETS
04	SF, Alameda	80	7.8/8.9, 0.0/1.1	88	205
			REGISTERED ENGINEER - CIVIL October 21, 1997 12-8-97 PLANS APPROVAL DATE		

The State of California or its officers or agents shall not be responsible for the accuracy or completeness of electronic copies of this plan sheet.

INTERIM SEISMIC RETROFIT PROJECT

EAST BAY 288 TRUSSES YERBA BUENA ISLAND

SAN FRANCISCO-OAKLAND BAY BRIDGE

VERTICAL MEMBER RETROFIT MISCELLANEOUS NOTES

DESIGN	BY E. A. Morris	5-97	CHECKED Don Lee	5-97
DETAILS	BY Ralph Nakagaki	5-97	CHECKED Don Lee	5-97
QUANTITIES	BY E. A. Morris	5-97	CHECKED Don Lee	5-97

STATE OF CALIFORNIA
DEPARTMENT OF TRANSPORTATION

DIVISION OF STRUCTURES
STRUCTURE DESIGN
TOLL BRIDGE SPECIAL ANALYSIS

BRIDGE NO.
33-0025
POST MILE
1.5

05 OSD 239 (CA08 3/95)

ORIGINAL SCALE IN INCHES
FOR REDUCED PLANS

CU 04
EA 043001

DISREGARD PRINTS BEARING
EARLIER REVISION DATES


REVISION DATES (PRELIMINARY STAGE ONLY)

SHEET 20 OF 36

USERNAME: trannda
boplr20vnr...09083816

DATE PLOTTED: 9-Dec-1997
TIME PLOTTED: 09:27


PART TYPICAL AT NORTH VERTICAL TRUSS (VPCPW) (VPCPE)										
LOCATION	PERFORATED COVER PLATE LIMITS					H.S. BOLT LIMITS			STIFFENER LIMITS	EDGE DISTANCE
	"a" (ft)	"b" (spaces)	"c" (ft)	"d" (ft)	"e" (ft)	"h" (spaces)	"j" (spacing)	"k" (spacing)	"f" (ft)	"m" (in)
YB1 LO-UO	25'-2 3/4"	5	3'-3"	3'-0"	1'-6"	5	32 @ 6"	12 @ 6"	3'-1 1/2"	2 1/4"
YB2 L8-U8	25'-7 1/4"	5	4'-0"	3'-0"	1'-6"	6	32 @ 6"	12 @ 6"	3'-1 1/2"	2 1/4"
YB2 L9-U9	26'-4 1/2"	5	3'-9"	3'-0"	1'-6"	8	32 @ 6"	12 @ 6"	3'-1 1/2"	2 1/4"
YB3 L17-U17	27'-8 1/2"	6	3'-6"	2'-9"	1'-3"	7	36 @ 6"	11 @ 6"	2'-7 1/2"	1 3/4"
YB3 L18-U18	27'-9"	6	3'-6"	2'-9"	1'-3"	7	36 @ 6"	11 @ 6"	2'-6"	1 3/4"
YB4 L26-U26	27'-8 1/4"	6	3'-6"	2'-9"	1'-3"	7	36 @ 6"	11 @ 6"	2'-7"	1 3/4"
YB4 L27-U27	27'-9"	6	3'-6"	2'-9"	1'-3"	7	36 @ 6"	11 @ 6"	2'-6"	1 3/4"
EI L35-U35	26'-2 1/4"	5	3'-8"	3'-0"	1'-6"	7	32 @ 6"	12 @ 6"	3'-1 1/2"	2 1/4"

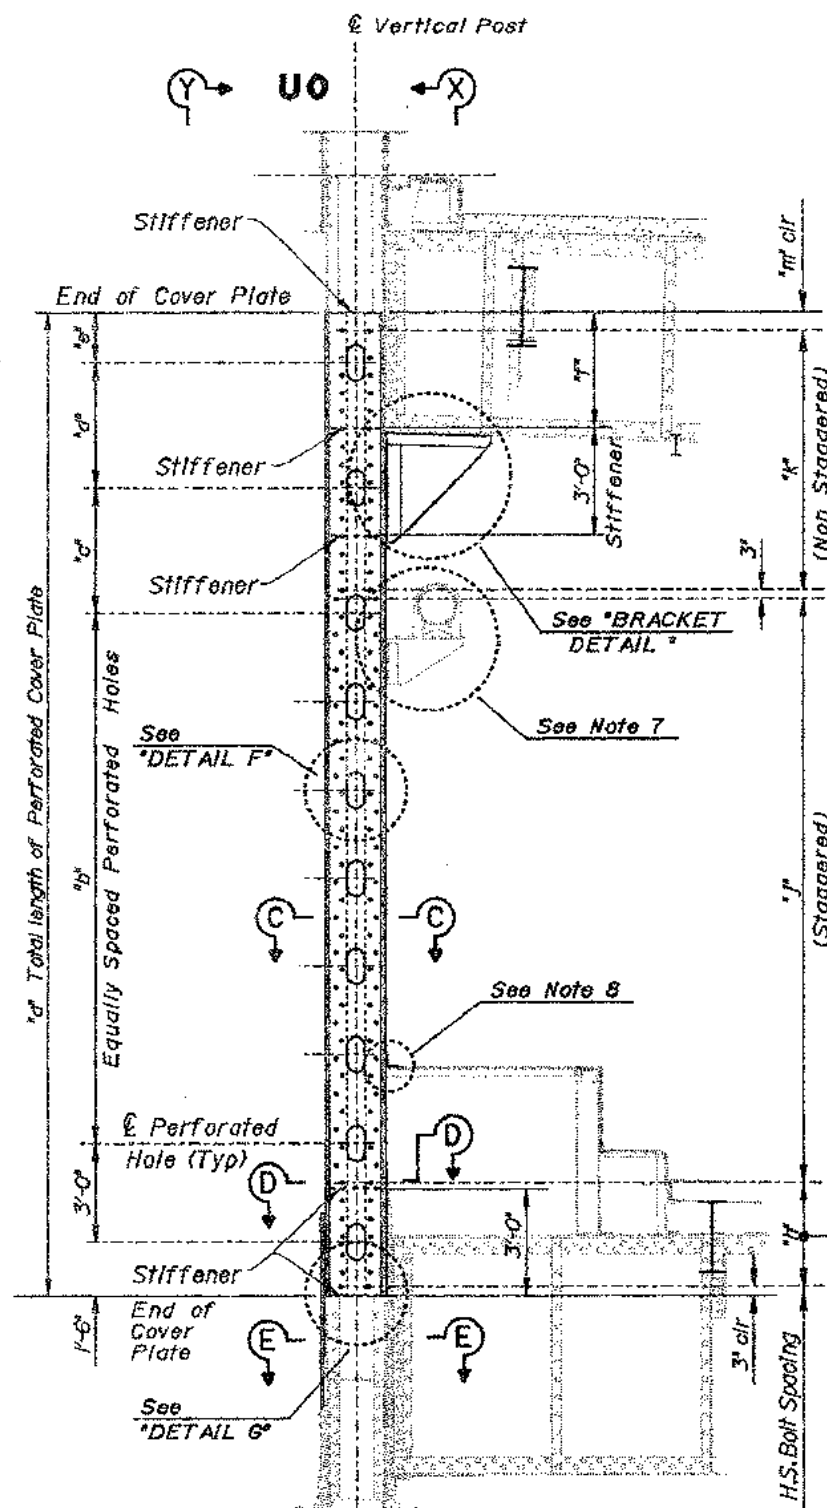

Notes:

1. VPCPW side shown VPCPE side similar.
2. See "VIEW Y-Y" for beginning limit of cover plate.

PART TYPICAL
3/8" - 1'-0"

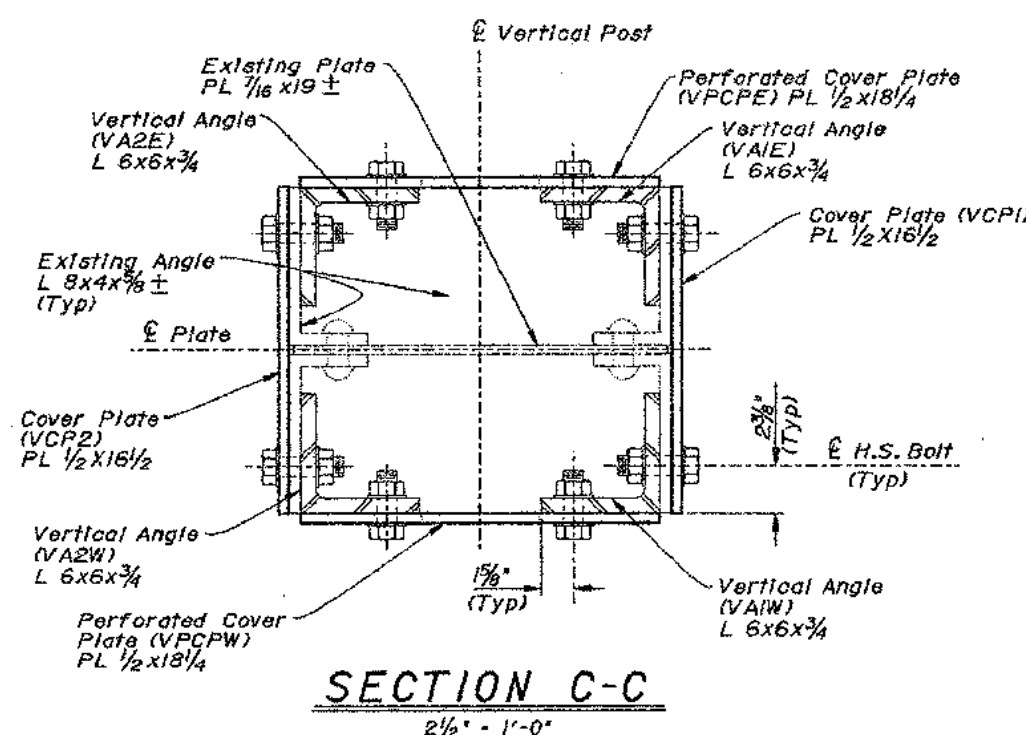

NOTE:

THE CONTRACTOR SHALL VERIFY ALL CONTROLLING FIELD DIMENSIONS BEFORE ORDERING OR FABRICATING ANY MATERIAL.

Notes:

1. For "VIEW X-X" see "VERTICAL MEMBER DETAIL NO. 2 (NORTH)" sheet.
2. For "VIEW Y-Y" see "VERTICAL MEMBER DETAIL NO. 3 (NORTH)" sheet.
3. For "SECTION D-D", "SECTION E-E" and "DETAIL F" see "MISCELLANEOUS DETAILS NO. 1" sheet.
4. For "DETAIL G" see "MISCELLANEOUS DETAILS NO. 3" sheet.
5. For "BRACKET DETAIL" see "MISCELLANEOUS DETAILS NO. 2" sheet.
6. For "STIFFENER DETAIL" see "MISCELLANEOUS DETAILS NO. 1" sheet.
7. For Temporary Utility Relocation see Road Plans.
8. For barrier temporary removal see "BARRIER DETAILS NO. 1" sheet. Platform brackets shall be temporarily removed as required and modified to accommodate new Cover Plate as per Engineer's approval.
9. Staggered Bolt pattern on VPCPW and VPCPE shall be installed so as not to interfere with adjacent VCP1 and VCP2.
10. For Installation Sequence see "VERTICAL MEMBER RETROFIT MISCELLANEOUS NOTES" sheet.

INTERIM SEISMIC RETROFIT PROJECT
EAST BAY 288 TRUSSES YERBA BUENA ISLAND
SAN FRANCISCO-OAKLAND BAY BRIDGE
VERTICAL MEMBER DETAIL NO. 1 (NORTH)

DESIGN	BY	5-97	CHECKED	5-97
DETAILS	BY	5-97	CHECKED	5-97
QUANTITIES	BY	5-97	CHECKED	5-97

STATE OF CALIFORNIA
DEPARTMENT OF TRANSPORTATION

DIVISION OF STRUCTURES
STRUCTURE DESIGN
TOLL BRIDGE SPECIAL ANALYSIS

BRIDGE NO.
33-0025
POST MILE
1.5

DIST.	COUNTY	ROUTE	POST MILES TOTAL PROJECT	SHEET NO.	TOTAL SHEETS
04	SF, Alameda	80	7.8/8.9. 0.0/1.1	90	205

REGISTERED ENGINEER CIVIL
October 21, 1997

12-8-97
PLANS APPROVAL DATE

THE STATE OF CALIFORNIA OR ITS OFFICERS OR AGENTS
SHALL NOT BE RESPONSIBLE FOR THE ACCURACY OR
COMPLETENESS OF ELECTRONIC COPIES OF THIS PLAN SHEET.

LEGEND



- Indicates existing structures.
- Indicates new structures.
- Indicates new 1" high strength bolts in 1/4" hole.
- Indicates existing 1" rivets to be removed and replaced with new 1" high strength bolts in existing 1/16" hole.
- Indicates approx. location of existing rivets.

PART TYPICAL AT NORTH VERTICAL TRUSS (VCP1)				
LOCATION	COVER PLATE	H.S. BOLT LIMITS		FILLER PLATE LIMITS*
	"aa" (ft)	"bb" (spacing)	"ee" (ft)	PLATE (VFPI)
YB1 LO-UO	22'-2 1/2"	31 @ 6"	6'-8 1/4"	3/16 x 1 1/2 x 2'-9"
YB2 L8-U8 L9-U9	22'-6 3/4" 23'-3 3/4"	32 @ 6" 32 @ 6"	6'-8 1/4" 6'-8 1/4"	3/16 x 1 1/2 x 2'-9" 1/4 x 1 1/2 x 3'-4 3/4"
YB3 L17-U17 L18-U18	25'-1 1/4" 25'-3 3/4"	36 @ 6" 36 @ 6"	6'-1 3/4" 6'-1 3/4"	1/4 x 1 1/2 x 3'-4 3/4" 1/4 x 1 1/2 x 3'-4 3/4"
YB4 L26-U26 L27-U27	25'-1 3/4" 25'-3"	36 @ 6" 36 @ 6"	6'-1 3/4" 6'-1 3/4"	1/4 x 1 1/2 x 3'-4 3/4" 1/4 x 1 1/2 x 3'-4 3/4"
E1 L35-U35	23'-1 1/2"	31 @ 6"	6'-8 1/4"	1/4 x 1 1/2 x 3'-4 3/4"

* See Note 4

ANNOTATION

- VAIE Vertical Angle, Deck side and East side
- VAIW Vertical Angle, Deck side and West side
- VA2E Vertical Angle, Outside and East side
- VA2W Vertical Angle, Outside and West side
- VCP1 Vertical Cover Plate, Deck side
- VCP2 Vertical Cover Plate, Outside
- VFPI Vertical Filler Plate, Deck side
- VFP2 Vertical Filler Plate, Outside
- VSP1E Vertical Splice Plate, Inside of VSP2E
- VSP1W Vertical Splice Plate, Inside of VSP2W
- VSP2E Vertical Splice Plate, Outside, East half
- VSP2W Vertical Splice Plate, Outside, West half
- VPCPE Vertical Perforated Cover Plate East side
- VPCPW Vertical Perforated Cover Plate West side

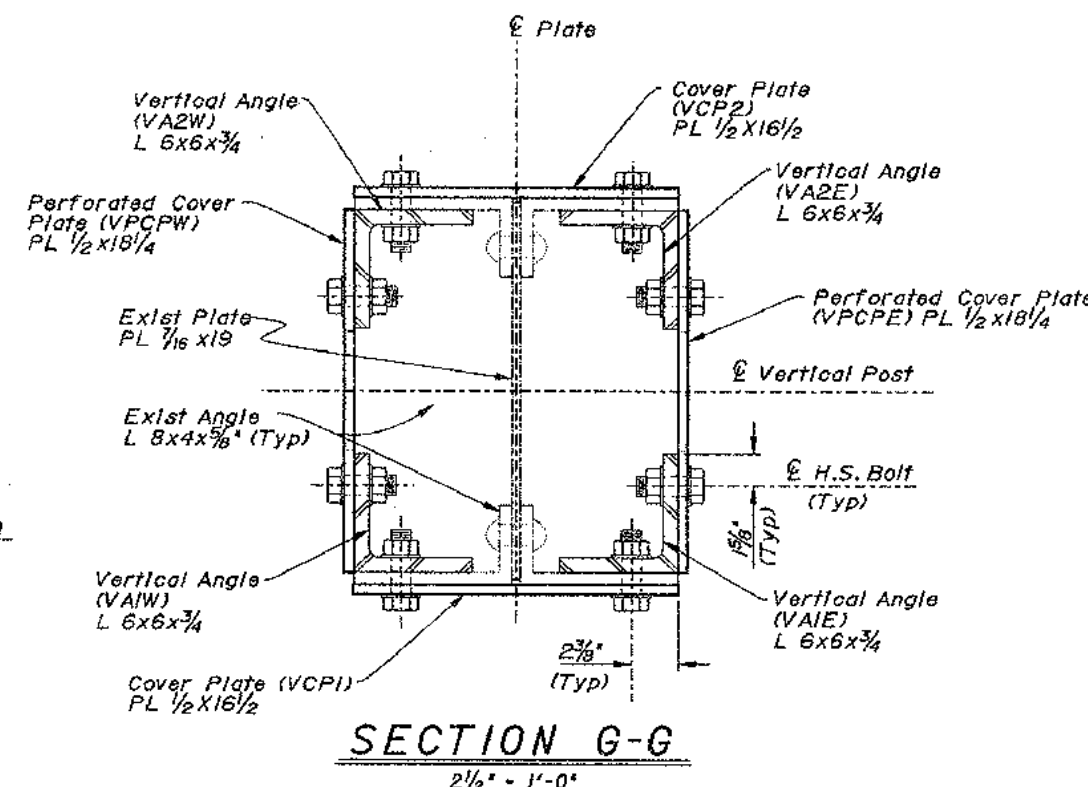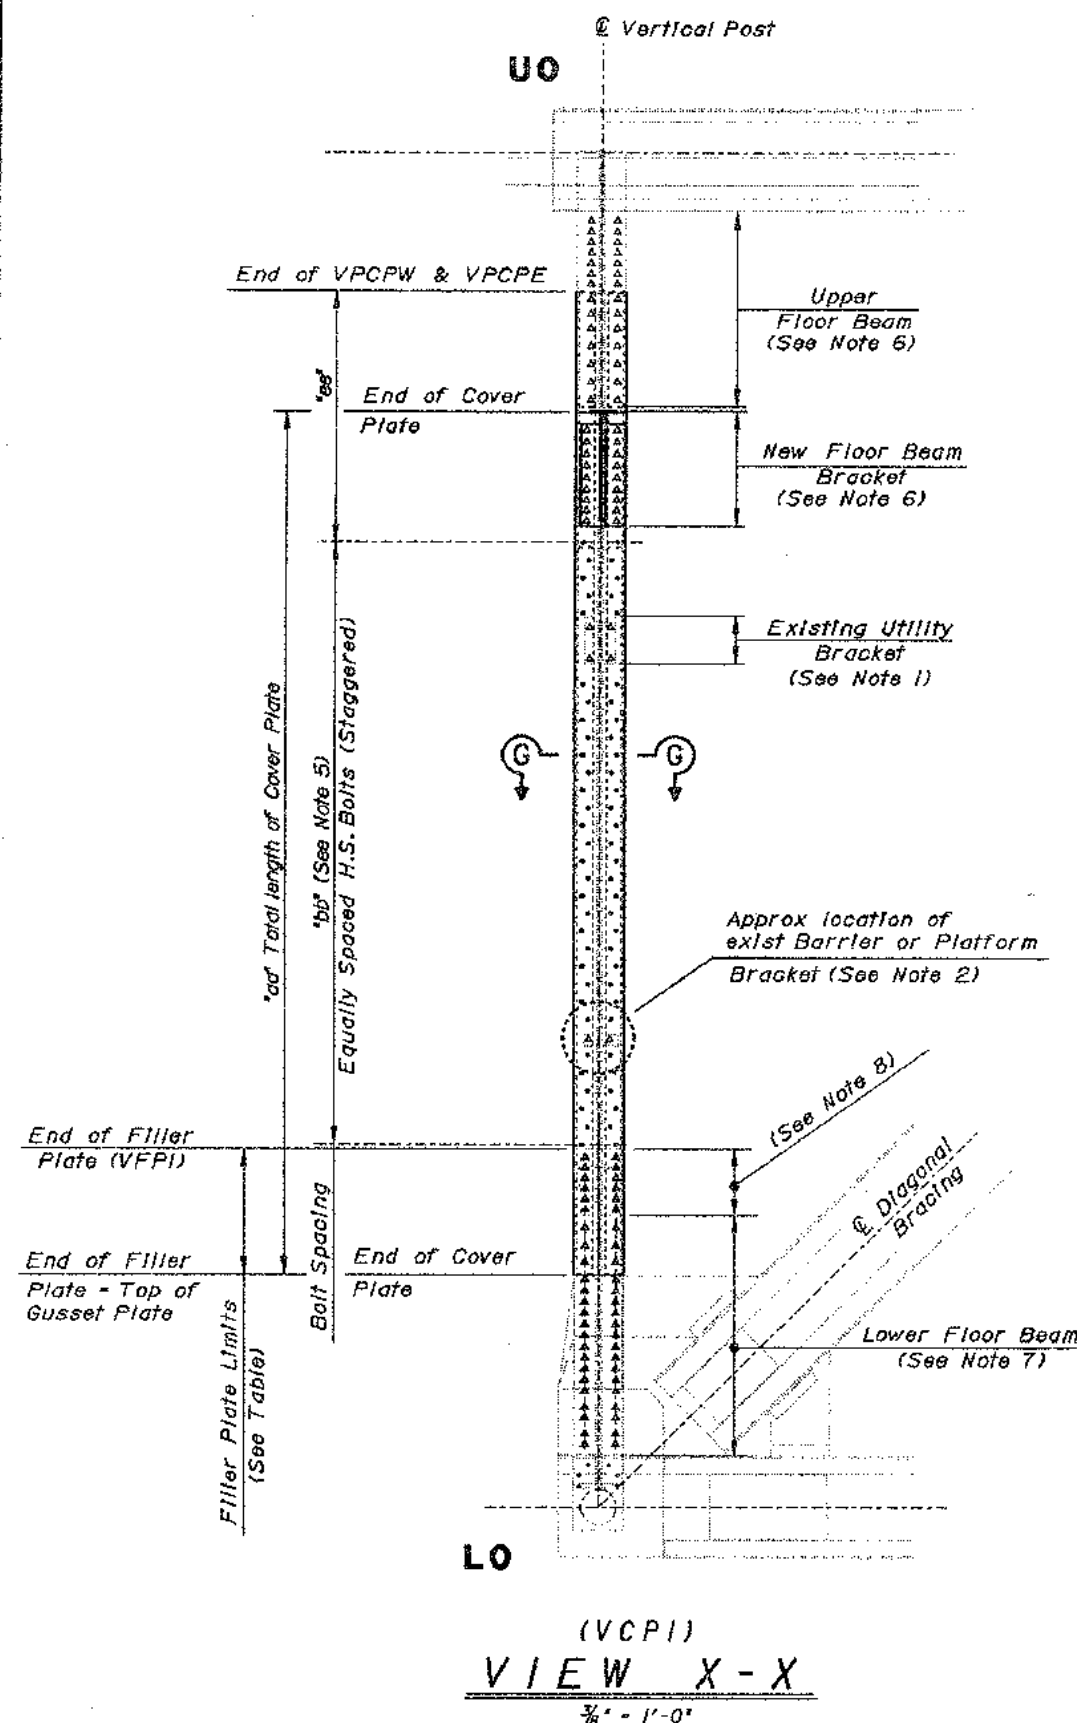

NOTE:
THE CONTRACTOR SHALL VERIFY ALL
CONTROLLING FIELD DIMENSIONS BEFORE
ORDERING OR FABRICATING ANY MATERIAL.

Notes:

- For Temporary Utility Relocation see Road Plans.
- For barrier temporary removal see "BARRIER DETAILS NO. 1" sheet. Platform brackets shall be temporarily removed as required and modified to accommodate new Cover Plate as per Engineer's approval.
- For Installation Sequence see "VERTICAL MEMBER RETROFIT MISCELLANEOUS NOTES" sheet.
- Existing Filler Plate shall be replaced with a new Filler Plate, into same location to accommodate new Cover Plate.
- Existing abandoned utility holes shall be used when possible in place of new 1/4" diameter holes.
- Upper Floor Beam has a total of 30 existing rivets except for "L17-U17", "L18-U18", "L26-U26" and "L27-U27", which have 28 rivets. The existing Floor Beam Bracket has 18 existing rivets.
- Lower Floor Beam has a total of 36 existing rivets.
- Existing Filler Plates have 12 existing rivets.

INTERIM SEISMIC RETROFIT PROJECT
EAST BAY 288 TRUSSES YERBA BUENA ISLAND
SAN FRANCISCO-OAKLAND BAY BRIDGE
VERTICAL MEMBER DETAIL NO. 2 (NORTH)

DESIGN	BY Gerrard Hight 5-97	CHECKED E.A. Morris 5-97
DETAILS	BY Ralph Nakagawa 5-97	CHECKED Don Lee 5-97
QUANTITIES	BY E.A. Morris 5-97	CHECKED Don Lee 5-97

STATE OF
CALIFORNIA
DEPARTMENT OF TRANSPORTATION

DIVISION OF STRUCTURES
STRUCTURE DESIGN
TOLL BRIDGE SPECIAL ANALYSIS

BRIDGE NO.	33-0025
POST MILE	1.5

CU 04
EA 043001

REVISION DATES (PRELIMINARY STAGE ONLY)	SHEET 22 OF 36
---	----------------

DIST.	COUNTY	ROUTE	POST MILES TOTAL PROJECT	SHEET NO.	TOTAL SHEETS
04	SF, Alameda	80	7.8/8.9, 0.0/1.1	91	205

REGISTERED ENGINEER - CIVIL
 October 21, 1997
 No. 50978
 Exp. 9-30-01
 CIVIL
 STATE OF CALIFORNIA

12-8-97
 PLANS APPROVAL DATE

The State of California or its officers or agents shall not be responsible for the accuracy or completeness of electronic copies of this plan sheet.

LEGEND

- Indicates existing structures.
- Indicates new structures.
- Indicates new 1" high strength bolts in 1/4" hole.
- ▲ Indicates existing 1" rivets to be removed and replaced with new 1" high strength bolts in existing 1/4" hole.
- Indicates approx. location of existing rivets.

ANNOTATION



- VAIE Vertical Angle, Deck side and East side
- VAIW Vertical Angle, Deck side and West side
- VA2E Vertical Angle, Outside and East side
- VA2W Vertical Angle, Outside and West side
- VCPI Vertical Cover Plate, Deck side
- VCP2 Vertical Cover Plate, Outside
- VFP1 Vertical Filler Plate, Deck side
- VFP2 Vertical Filler Plate, Outside
- VSP1E Vertical Splice Plate, Inside of VSP2E
- VSP1W Vertical Splice Plate, Inside of VSP2W
- VSP2E Vertical Splice Plate, Outside, East half
- VSP2W Vertical Splice Plate, Outside, West half
- VPCPE Vertical Perforated Cover Plate East side
- VPCPW Vertical Perforated Cover Plate West side

Notes:

- For Temporary Utility Relocation see Road Plans.
- For barrier temporary removal see "BARRIER DETAILS NO. 1" sheet. Platform brackets shall be temporarily removed as required and modified to accommodate new Cover Plate as per Engineer's approval.
- Total of 22 existing rivets to be removed, except at L0-U0 and L8-U8 which have 24 existing rivets.
- Existing abandoned utility holes shall be used when possible in place of new 1/4" diameter holes.
- For installation Sequence see "VERTICAL MEMBER RETROFIT MISCELLANEOUS NOTES" sheet

PART TYPICAL AT NORTH VERTICAL TRUSS (VCP2)							
LOCATION	COVER PLATE	H. S. BOLT LIMITS		EXISTING EDGE DISTANCE	SPlice PLATE LIMITS		
	"aaa" (ft)	"bbb" (spaces)	"ccc" (spaces)	"fff" (in)	OUTSIDE PLATE* (VSP2)	MIDDLE PLATE* (VSP1)	FILLER PLATE (VFP2)
YB1 L0-U0	25'-2 3/4"	31 @ 6"	12 @ 6"	2 1/4"	3/4 x 8 1/4 x 6' - 8 5/8"	5/8 x 8 1/4 x 4' - 8 1/2"	1/4 x 16 1/2 x 2' - 6"
YB2 L8-U8	25'-7 1/4"	32 @ 6"	12 @ 6"	2 1/4"	3/4 x 8 1/4 x 6' - 8 3/4"	5/8 x 8 1/4 x 4' - 8 1/2"	1/4 x 16 1/2 x 2' - 6"
YB2 L9-U9	26'-4 1/2"	33 @ 6"	12 @ 6"	2 1/4"	3/4 x 8 1/4 x 6' - 1"	5/8 x 8 1/4 x 4' - 8 1/2"	1/4 x 16 1/2 x 2' - 6"
YB3 L17-U17	27'-8 1/2"	37 @ 6"	11 @ 6"	1 3/4"	3/4 x 8 1/4 x 6' - 1"	5/8 x 8 1/4 x 4' - 4 1/2"	1/4 x 16 1/2 x 2' - 6"
YB3 L18-U18	27'-9"	37 @ 6"	11 @ 6"	1 3/4"	3/4 x 8 1/4 x 6' - 1"	5/8 x 8 1/4 x 4' - 4 1/2"	1/4 x 16 1/2 x 2' - 6"
YB4 L26-U26	27'-8 1/4"	37 @ 6"	11 @ 6"	1 3/4"	3/4 x 8 1/4 x 6' - 1"	5/8 x 8 1/4 x 4' - 4 1/2"	1/4 x 16 1/2 x 2' - 6"
YB4 L27-U27	27'-9"	37 @ 6"	11 @ 6"	1 3/4"	3/4 x 8 1/4 x 6' - 1"	5/8 x 8 1/4 x 4' - 4 1/2"	1/4 x 16 1/2 x 2' - 6"
E1 L35-U35	26'-2 1/4"	33 @ 6"	12 @ 6"	2 1/4"	3/4 x 8 1/4 x 6' - 1"	5/8 x 8 1/4 x 4' - 4 1/2"	1/4 x 16 1/2 x 2' - 6"

* 2 plates per location

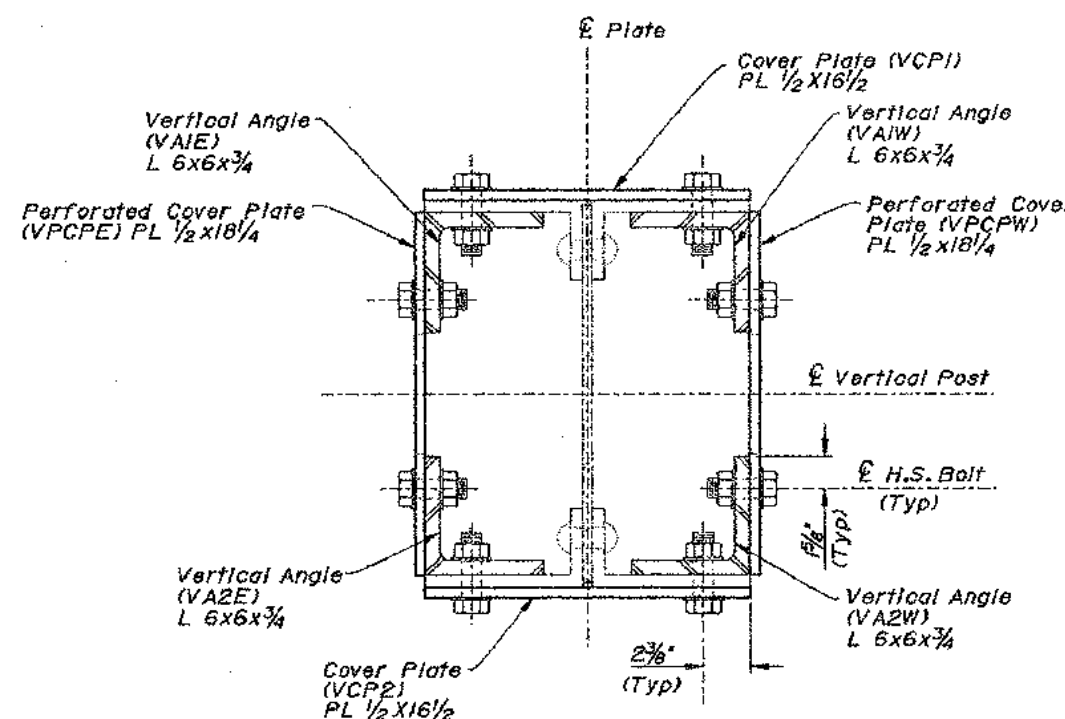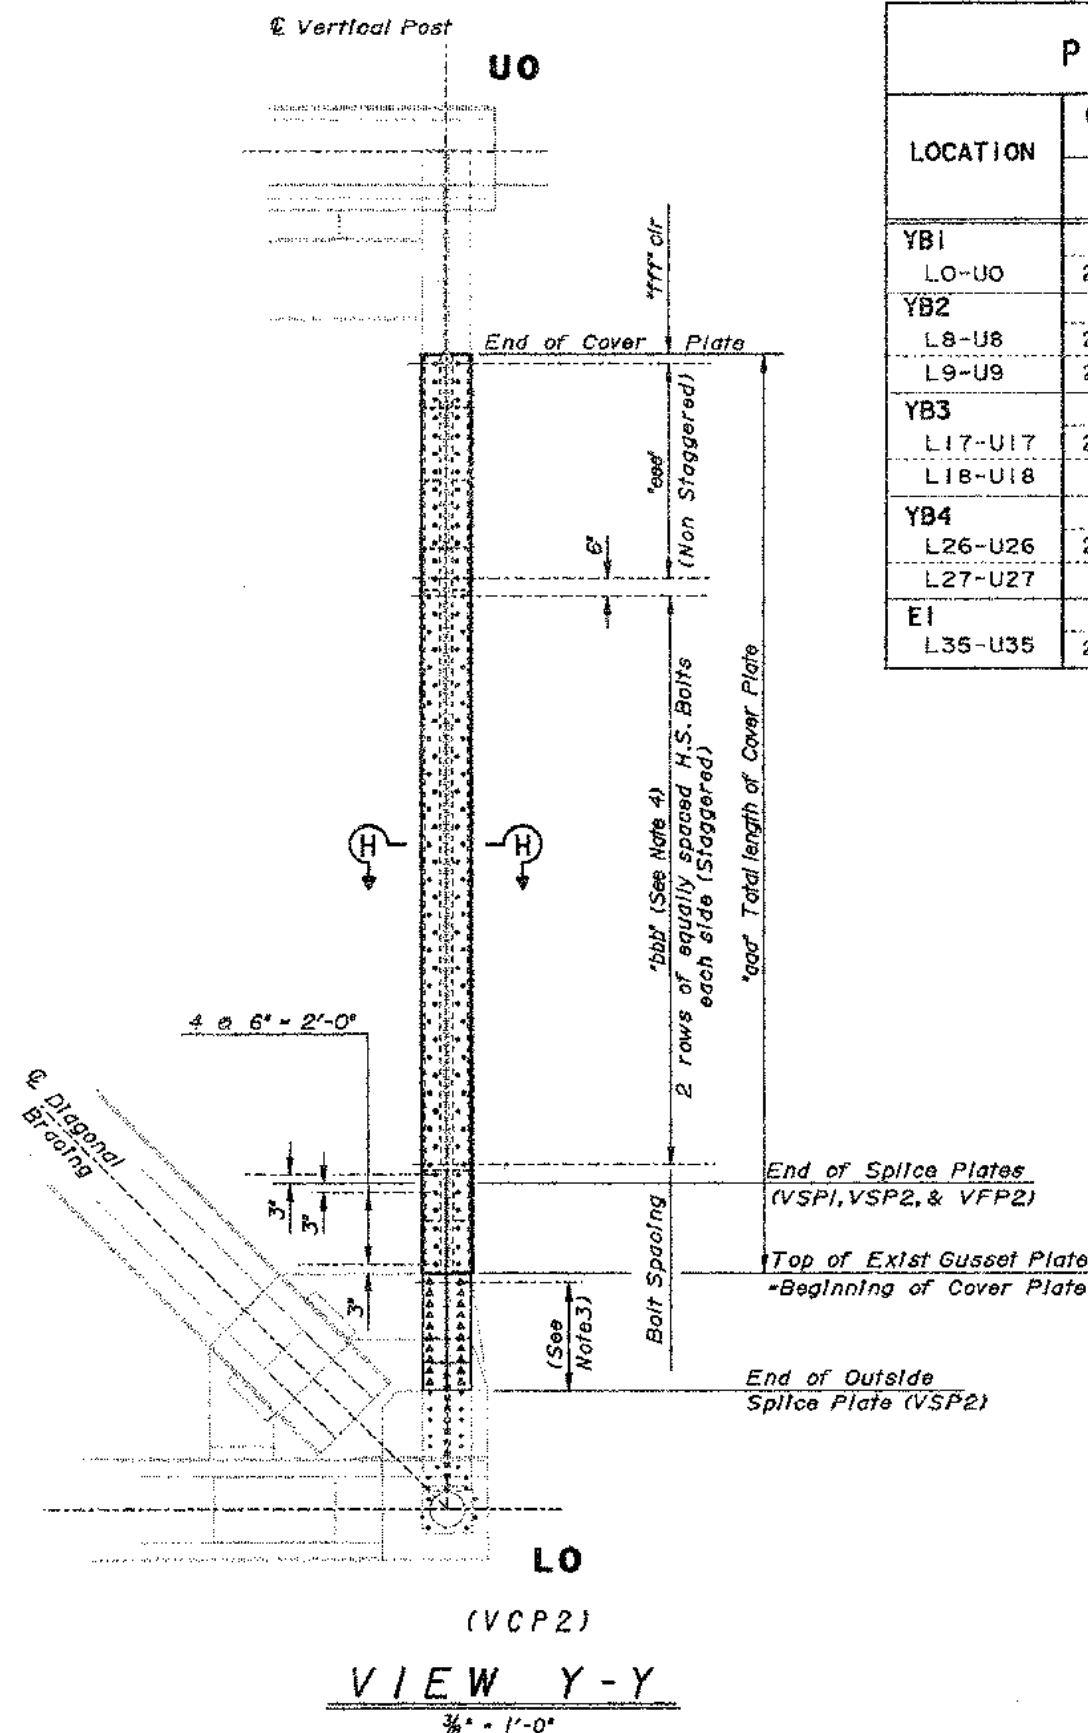

SECTION H-H
2 1/2" = 1'-0"


DESIGN	BY	5-97	CHECKED	5-97
DETAILS	BY	5-97	CHECKED	5-97
QUANTITIES	BY	5-97	CHECKED	5-97

STATE OF CALIFORNIA
 DEPARTMENT OF TRANSPORTATION

DIVISION OF STRUCTURES
 STRUCTURE DESIGN
 TOLL BRIDGE SPECIAL ANALYSIS

BRIDGE NO.	33-0025
POST MILE	1.5

INTERIM SEISMIC RETROFIT PROJECT
 EAST BAY 288 TRUSSES YERBA BUENA ISLAND
 SAN FRANCISCO-OAKLAND BAY BRIDGE
 VERTICAL MEMBER DETAIL NO. 3 (NORTH)

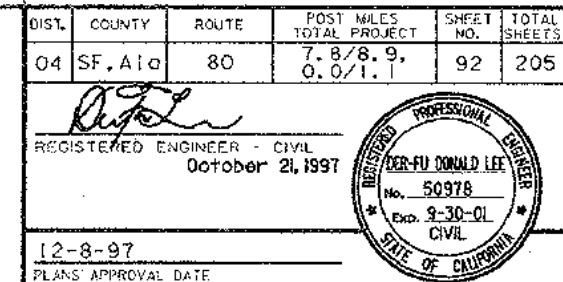

LOCATION	PERFORATED COVER PLATE LIMITS	H. S. BOLT LIMITS		DRAINAGE PIPE
	"a" (ft)	"e" (spaces)	"f"	(see Note 7)
YB1				
LO-UOA	25' - 2 $\frac{3}{4}$ "	12	24 @ 6"	East Side
YB2				
L8-U8A	25' - 1 $\frac{3}{4}$ "	8	29 @ 6"	-
L9-U9A	25' - 7 $\frac{3}{4}$ "	10	28 @ 6"	-
YB3				
L17-U17A	25' - 3 $\frac{1}{4}$ "	12	24 @ 6"	-
L18-U18A	25' - 2 $\frac{1}{2}$ "	12	24 @ 6"	West Side
YB4				
L26-U26A	25' - 3 $\frac{1}{4}$ "	12	24 @ 6"	-
L27-U27A	25' - 2 $\frac{1}{2}$ "	12	24 @ 6"	-
E1				
L35-U35A	25' - 9 $\frac{1}{4}$ "	12	25 @ 6"	-

DESIGN	BY	Gerrard Night	5-97	CHECKED	E.A. Morris	5-97	STATE OF CALIFORNIA DEPARTMENT OF TRANSPORTATION	DIVISION OF STRUCTURES STRUCTURE DESIGN TOLL BRIDGE SPECIAL ANALYSIS
DETAILS	BY	Ralph Nakaoka	5-97	CHECKED	Don Lee	5-97		
QUANTITIES	BY	E.A. Morris	5-97	CHECKED	Don Lee	5-97		

BRIDGE NO.
33-0025
POST MILE

VERTICAL MEMBER DETAIL NO. 4 (SOUTH)

DISREGARD PRINTS BEARING
EARLIER REVISION DATES

REVISION DATES (PRELIMINARY STAGE ONLY)									SHEET	OF	
6-8-97	5-20-97	5-2-97	8-2-97	6-5-97	6-20-97	6-28-97	6-27-97	8-22-97	KD 2-97	24	36

```

      USERNAME -> traningda
                  bopir244+4 0108384


```

DIST.	COUNTY	ROUTE	POST MILES TOTAL PROJECT	SHEET NO.	TOTAL SHEETS
04	SF. Alq	80	7.8/8.9, 0.0/1.1	93	205

REGISTERED ENGINEER - CIVIL
October 21, 1997

12-8-97
PLANS APPROVAL DATE

The State of California or its officers or agents shall not be responsible for the accuracy or completeness of electronic copies of this plan sheet.

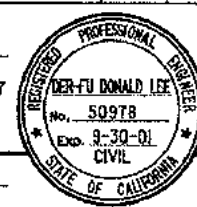

PART TYPICAL AT SOUTH VERTICAL TRUSS (VPCI)

LOCATION	COVER PLATE LIMITS "aa" (ft)	H.S. BOLT LIMITS "bb" (spaces)	BOLT SPACINGS "ff" (spaces)	FILLER PLATE LIMITS* FILLER PLATE (VFP1)
YB1 LO-UOA	21'-2 1/2"	24 @ 6"	9	5/8 x 16 1/2
YB2 L8-U8A L9-U9A	21'-1 1/2"	29 @ 6" 28 @ 6"	4 6	5/8 x 16 1/2 1/4 x 16 1/2
YB3 L17-U17A L18-U18A	20'-9 1/4"	24 @ 6" 24 @ 6"	9 9	1/4 x 16 1/2 1/4 x 16 1/2
YB4 L26-U26A L27-U27A	20'-9" 20'-8 1/2"	24 @ 6" 24 @ 6"	9 9	1/4 x 16 1/2 1/4 x 16 1/2
E1 L35-U35A	21'-2 1/4"	25 @ 6"	9	1/4 x 16 1/2

* See Note 4

LEGEND

- Indicates existing structures.
- Indicates new structures.
- Indicates new 1" high strength bolts in 1/4" holes.
- ▲ Indicates existing 1" rivets to be removed and replaced with new 1" high strength bolts in existing 1 1/16" hole.
- Indicates approx. location of existing rivets.

ANNOTATION


- VAIE Vertical Angle, Deck side and East side
- VAIW Vertical Angle, Deck side and West side
- VA2E Vertical Angle, Outside and East side
- VA2W Vertical Angle, Outside and West side
- VCP1 Vertical Cover Plate, Deck side
- VCP2 Vertical Cover Plate, Outside
- VFP1 Vertical Filler Plate, Deck side
- VFP2 Vertical Filler Plate, Outside
- VSP1E Vertical Splice Plate, Inside of VSP2E
- VSP1W Vertical Splice Plate, Inside of VSP2W
- VSP2E Vertical Splice Plate, Outside, East half
- VSP2W Vertical Splice Plate, Outside, West half
- VPCPE Vertical Perforated Cover Plate East side
- VPCPW Vertical Perforated Cover Plate West side

Notes:

- For Temporary Utility Relocation see Road Plans.
- For barrier temporary removal see "BARRIER DETAILS NO. 1" sheet. Platform brackets shall be temporarily removed as required and modified to accommodate new Cover Plate as per Engineer's approval.
- For Installation Sequence see "VERTICAL MEMBER RETROFIT MISCELLANEOUS NOTES" sheet.
- Existing Filler Plate shall be replaced with a new Filler Plate, into same location to accommodate new Cover Plate.
- Existing abandoned utility holes shall be used when possible in place of new 1/4" diameter holes.
- Upper Floor Beam has a total of 30 existing rivets. The existing Floor Beam Bracket has 18 existing rivets.
- Lower Floor Beam has a total of 36 existing rivets.

SECTION G-G

2 1/2" - 1'-0"

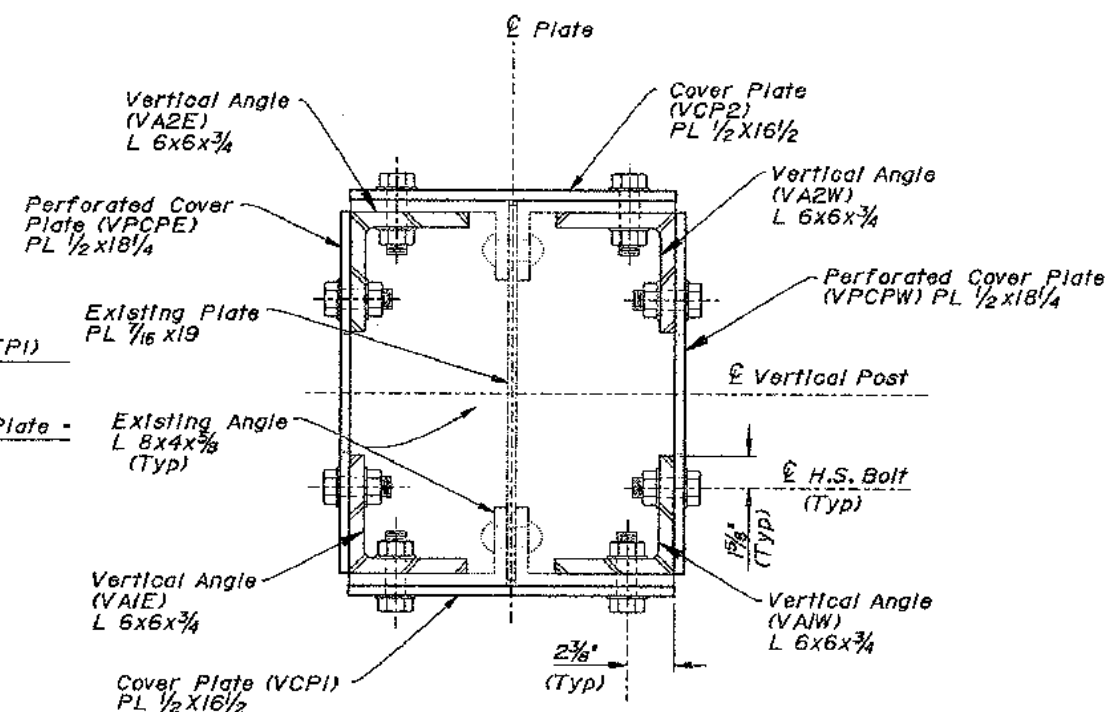

(VCP1)
VIEW X-X
3/8" - 1'-0"

NOTE:
THE CONTRACTOR SHALL VERIFY ALL CONTROLLING FIELD DIMENSIONS BEFORE ORDERING OR FABRICATING ANY MATERIAL.


DESIGN	BY Gerrard Hight	5-97	CHECKED E. A. Morris	5-97
DETAILS	BY Ralph Nakagawa	5-97	CHECKED Don Lee	5-97
QUANTITIES	BY E. A. Morris	5-97	CHECKED Don Lee	5-97


STATE OF
CALIFORNIA
DEPARTMENT OF TRANSPORTATION

DIVISION OF STRUCTURES
STRUCTURE DESIGN
TOLL BRIDGE SPECIAL ANALYSIS

BRIDGE NO.	33-0025
POST MILE	1.5

INTERIM SEISMIC RETROFIT PROJECT
EAST BAY 288 TRUSSES YERBA BUENA ISLAND
SAN FRANCISCO-OAKLAND BAY BRIDGE
VERTICAL MEMBER DETAIL NO. 5 (SOUTH)


 REGISTERED ENGINEER - CIVIL
 October 21, 1997
 12-8-97
 PLANS APPROVAL DATE



LEGEND

- ANNOTATION

- Notes:**

1. For Temporary Utility Relocation see Road Plans.
2. For barrier temporary removal see "BARRIER DETAILS NO. 1" sheet. Platform bracket shall be temporarily removed as required and modified to accommodate new Cover Plate as per Engineer's approval.
3. Total of 22 existing rivets to be replaced by H.S. bolts except at LO-UOA and LB-USA, which have 24 rivets
4. Existing abandoned utility holes shall be used when possible in place of new 1 1/4" diameter holes.
5. For Installation Sequence see "VERTICAL MEMBER RETROFIT MISCELLANEOUS NOTES" sheet.

NOTE:
THE CONTRACTOR SHALL VERIFY ALL
CONTROLLING FIELD DIMENSIONS BEFORE
ORDERING OR FABRICATING ANY MATERIAL.

INTERIM SEISMIC RETROFIT PROJECT
EAST BAY 288 TRUSSES YERBA BUENA ISLAND
SAN FRANCISCO-OAKLAND BAY BRIDGE
VERTICAL MEMBER DETAIL NO. 6 (SOUTH)


	DESIGN	BY Serrard Hight	5-97	CHECKED E. A. Morris	5-9
	DETAILS	BY Ralph Nakagawa	5-97	CHECKED Don Lee	5-9
	QUANTITIES	BY E. A. Morris	5-97	CHECKED Don Lee	5-9

STATE OF CALIFORNIA DEPARTMENT OF TRANSPORTATION	DIVISION OF STRUCTURES STRUCTURE DESIGN TOLL BRIDGE SPECIAL ANALYSIS
---	---

BRIDGE NO.	33-0025
POST MILE	1.5


REVISION DATES BY REVISION STAGE ONLY										ENCL	OF
DISCARD PRINTS BEARING EARLIER REVISION DATES										26	36
5-2-97	5-2-97	5-2-97	5-2-97	5-2-97	5-2-97	5-2-97	5-2-97	5-2-97			

USERNAME => trannda
 bopir26d46 090836C7

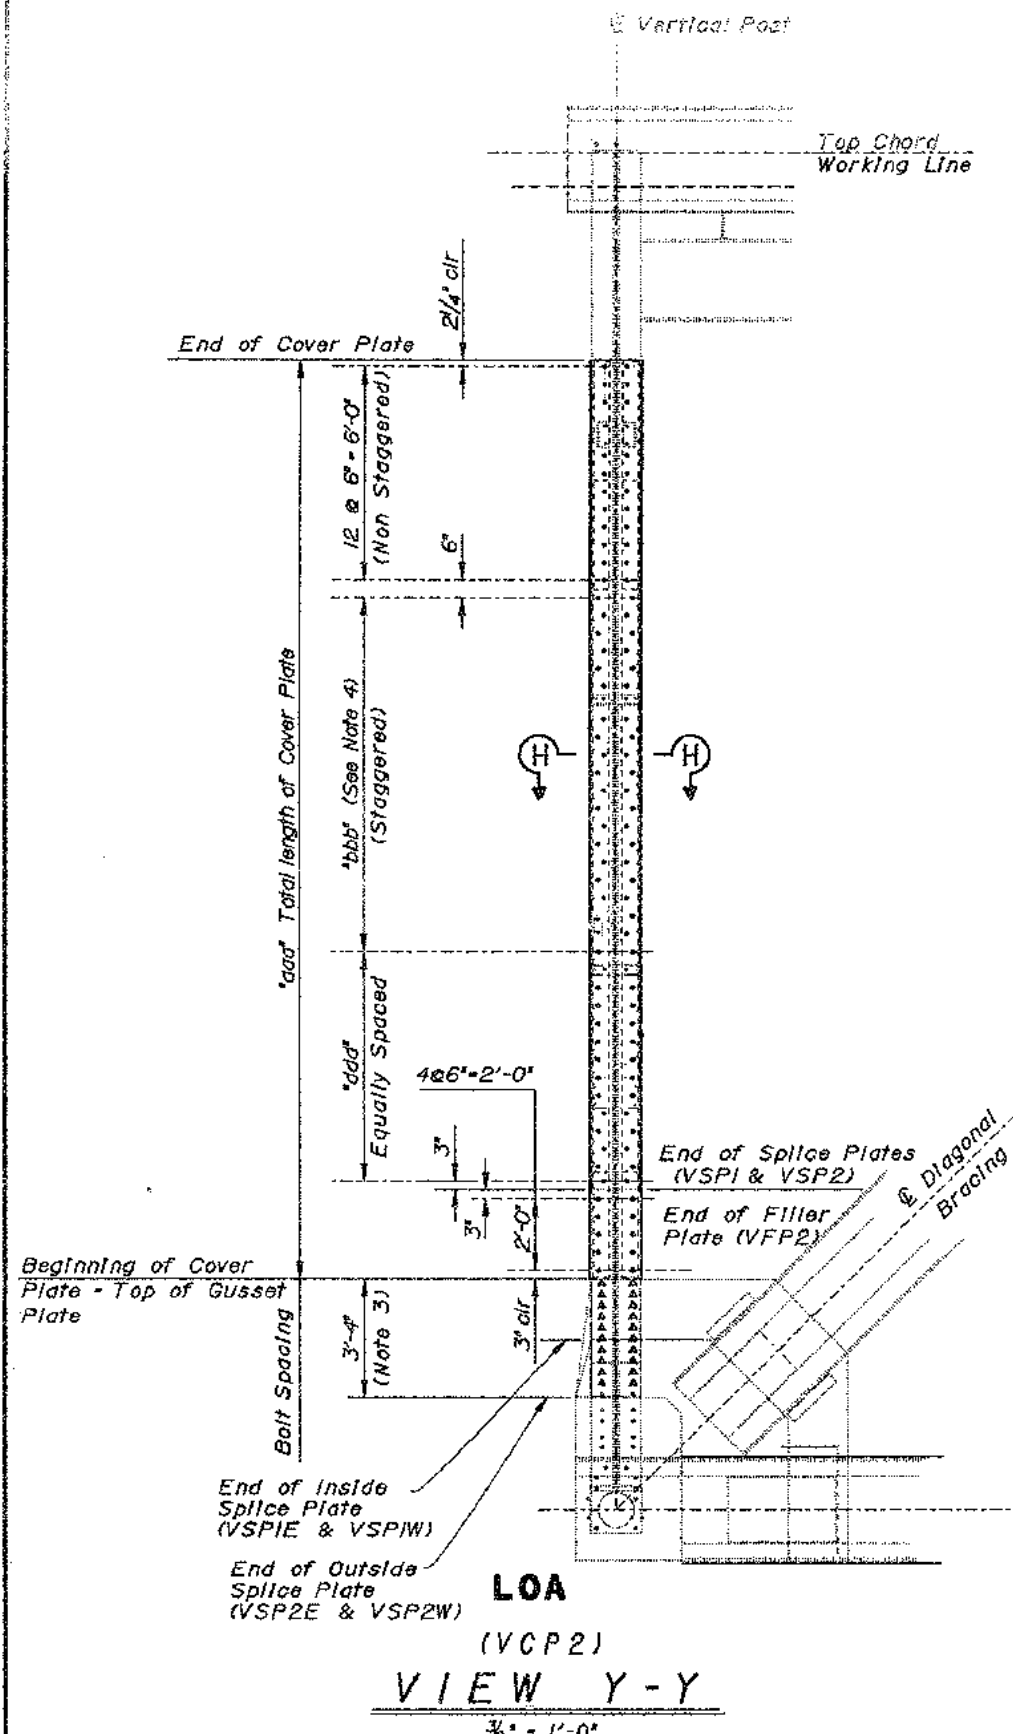

PART TYPICAL AT SOUTH VERTICAL TRUSS (VCP2)						
LOCATION	COVER PLATE	H. S. BOLT LIMITS		SPLICE PLATE LIMITS		
	"aaa" (ft)	"bbb" (spaces)	"ddd" (spaces)	OUTSIDE PLATE* (VSP2)	MIDDLE PLATE* (VSP1)	FILLER PLATE (VFP2)
YB1 L0-U0A	25' - 2 3/4"	24 @ 6"	8	3/4 x 8/4 x 6' - 8 5/8"	5/8 x 8/4 x 4' - 8/2"	1/4 x 16/2 x 2' - 6"
YB2 L8-U8A	25' - 1 3/4"	29 @ 6"	3	3/4 x 8/4 x 6' - 8 3/4"	5/8 x 8/4 x 4' - 8/2"	1/4 x 16/2 x 2' - 6"
L9-U9A	25' - 7/4"	28 @ 6"	5	3/4 x 8/4 x 6' - 3"	3/4 x 8/4 x 4' - 6/2"	1/4 x 16/2 x 2' - 6"
YB3 L17-U17A	25' - 3/4"	24 @ 6"	8	3/4 x 8/4 x 6' - 3/4"	3/4 x 8/4 x 4' - 6 3/4"	1/4 x 16/2 x 2' - 6"
L18-U18A	25' - 2 1/2"	24 @ 6"	8	3/4 x 8/4 x 6' - 3/4"	3/4 x 8/4 x 4' - 6 3/4"	1/4 x 16/2 x 2' - 6"
YB4 L26-U26A	25' - 3/4"	24 @ 6"	8	3/4 x 8/4 x 6' - 3/4"	3/4 x 8/4 x 4' - 6 3/4"	1/4 x 16/2 x 2' - 6"
L27-U27A	25' - 2 1/2"	24 @ 6"	8	3/4 x 8/4 x 6' - 3/4"	3/4 x 8/4 x 4' - 6 3/4"	1/4 x 16/2 x 2' - 6"
E1 L35-U35A	25' - 9/4"	25 @ 6"	8	3/4 x 8/4 x 6' - 2 1/4"	3/4 x 8/4 x 4' - 5 3/4"	1/4 x 16/2 x 2' - 6"

*2 plates per location.

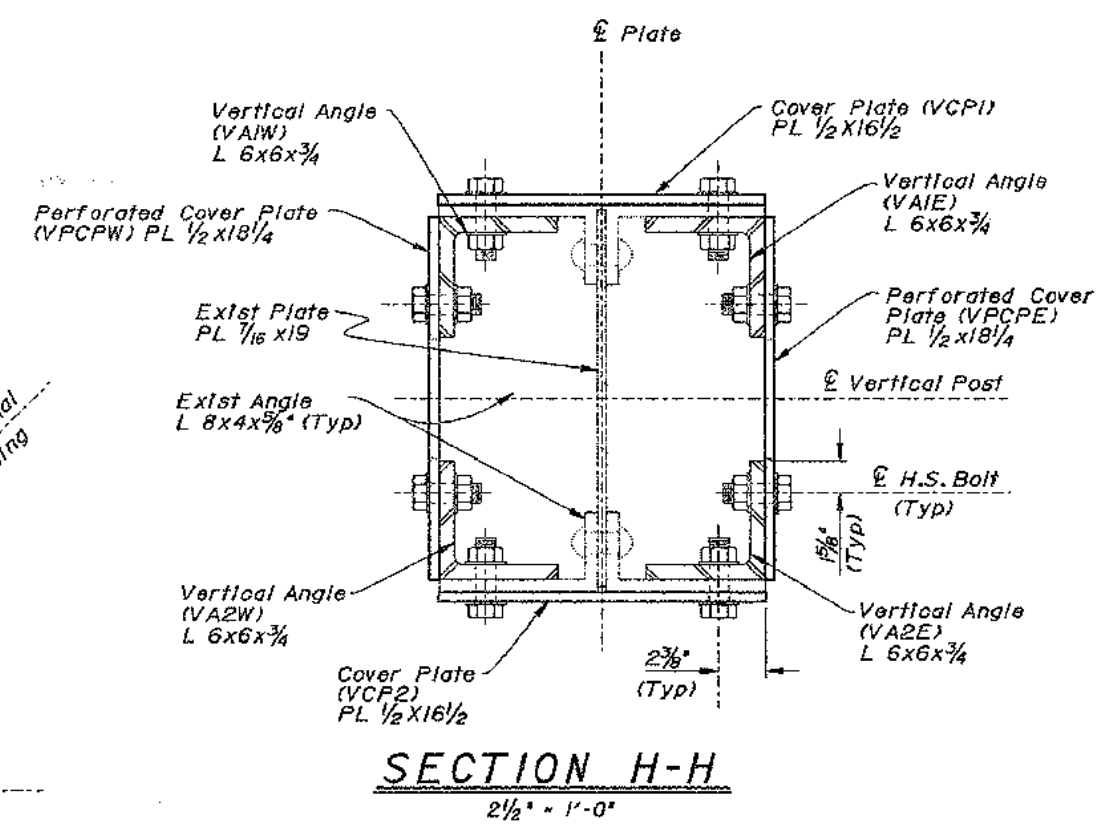


SECTION H-H
2½" x 1'-0"

LEGEND


- Indicates existing structures.
- Indicates new structures.
- Indicates new 1" high strength bolts in 1/4" hole.
- ▲ Indicates existing rivets to be removed and replaced with new high strength bolts in existing holes.
- Indicates approx. location of existing rivets.

ANNOTATION


VCPI Vertical Cover Plate Deck side

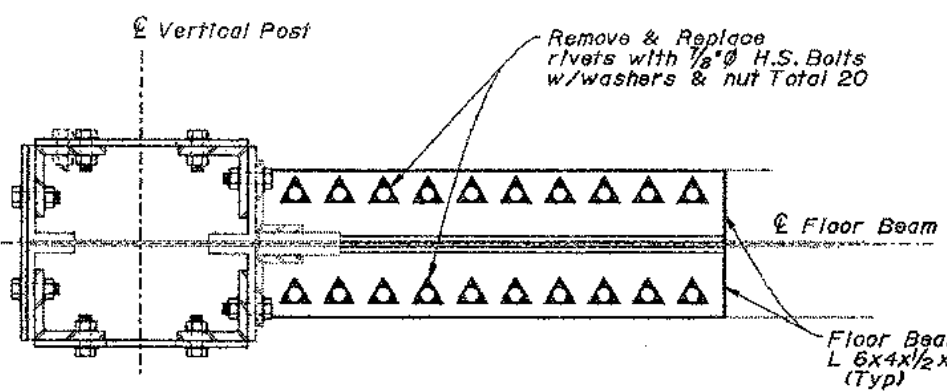


VIEW C-C
1/2" - 1'-0"

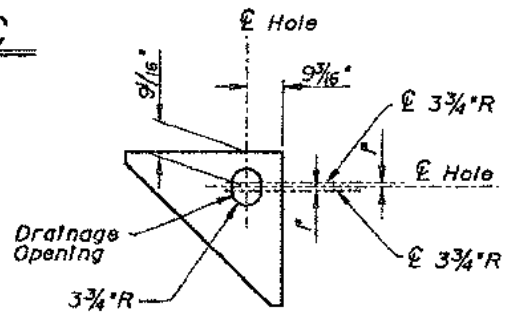

DETAIL H
1/2" - 1'-0"

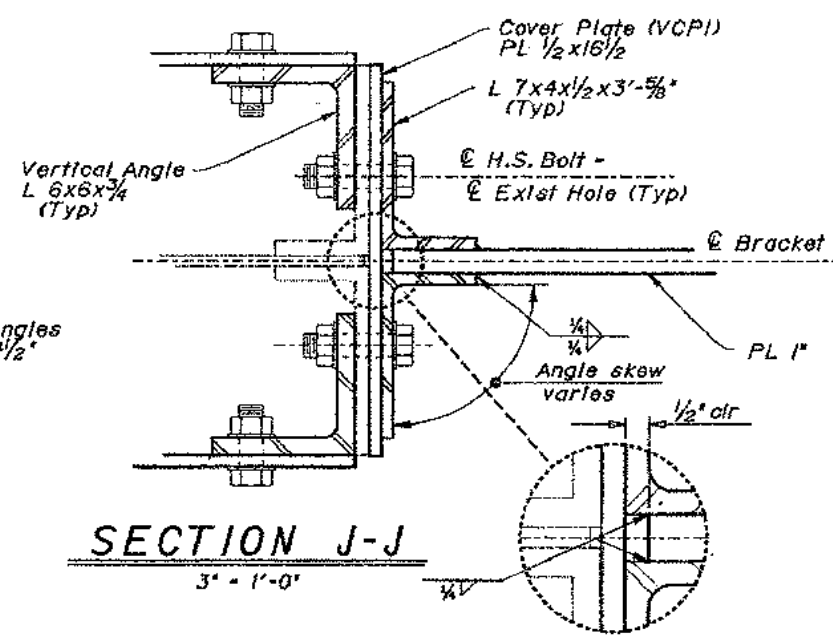


SECTION J-J
3" - 1'-0"

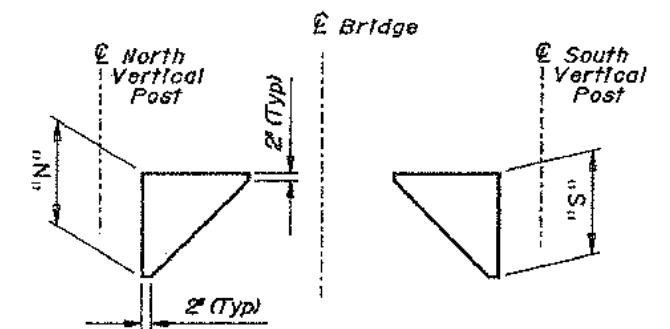


Note: For Dimensions "N" and "S" see "BRACKET PLATE DIMENSION" table.

BRACKET PLATE DIMENSION		
LOCATION	NORTH TRUSS ("N")	SOUTH TRUSS ("S")
YB1 L0-U0	3'-3 1/2"	3'-3 1/2"
YB2 L8-U8	3'-3 1/2"	3'-3 1/2"
YB2 L9-U9	3'-3 1/2"	3'-3 1/2"
YB3 L17-U17	3'-4"	3'-4"
YB3 L18-U18	3'-5"	* 3'-5"
YB4 L26-U26	3'-3 3/4"	3'-5"
YB4 L27-U27	3'-4 3/4"	3'-5"
EI L35-U35	3'-3 1/2"	3'-3 3/4"


* This location requires accommodating existing drainage pipe see DETAIL H.

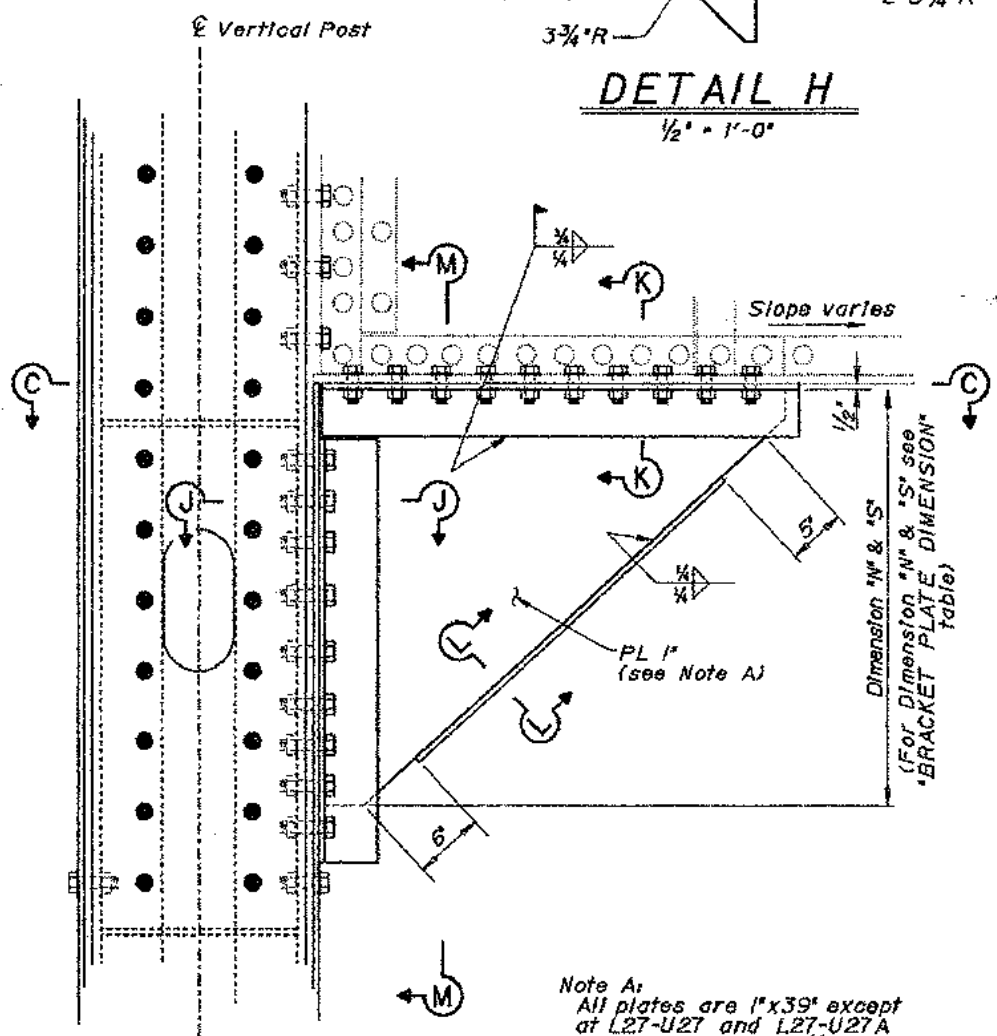


BRACKET DETAIL
1 1/2" - 1'-0"

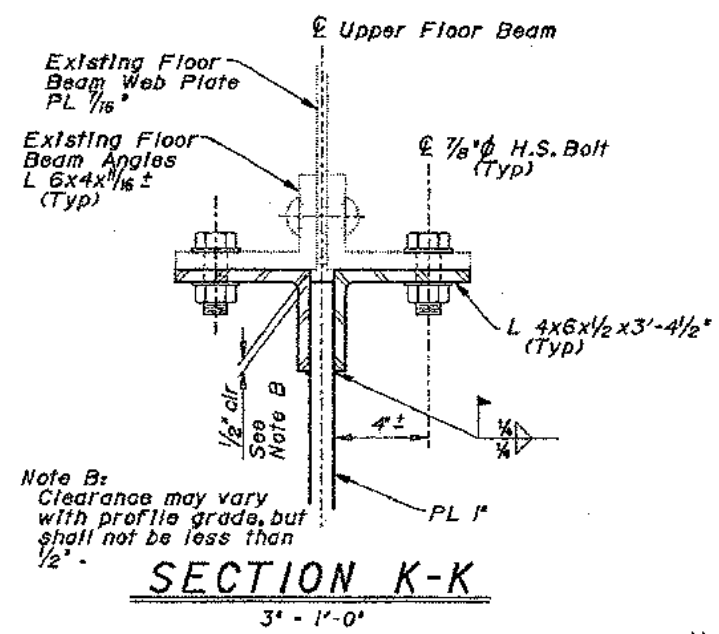

SECTION K-K
3" - 1'-0"

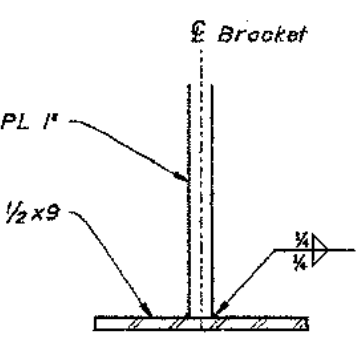

SECTION L-L
3" - 1'-0"

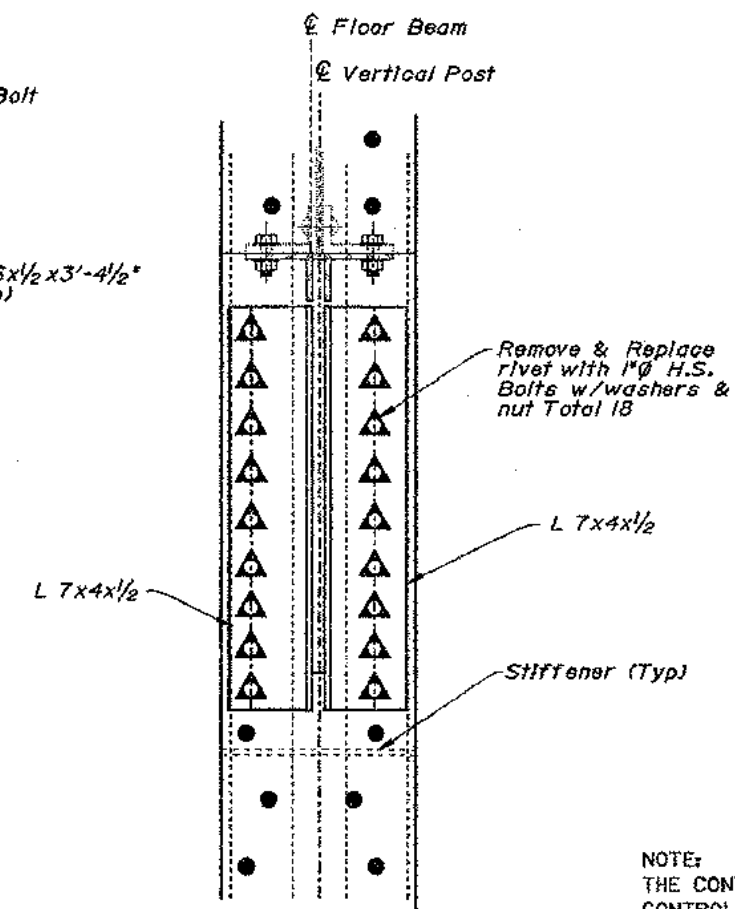

VIEW M-M
1 1/2" - 1'-0"

NOTE: THE CONTRACTOR SHALL VERIFY ALL CONTROLLING FIELD DIMENSIONS BEFORE ORDERING OR FABRICATING ANY MATERIAL.

INTERIM SEISMIC RETROFIT PROJECT

EAST BAY 288 TRUSSES YERBA BUENA ISLAND

SAN FRANCISCO-OAKLAND BAY BRIDGE

MISCELLANEOUS DETAILS NO. 2

DESIGN	BY E.A. Morris	CHECKED Don Lee	DATE 5-97
DETAILS	BY Ralph Nakagaki	CHECKED Don Lee	DATE 5-97
QUANTITIES	BY E.A. Morris	CHECKED Don Lee	DATE 5-97

STATE OF CALIFORNIA	DIVISION OF STRUCTURES	BRIDGE NO. 33-0025
DEPARTMENT OF TRANSPORTATION	STRUCTURE DESIGN	POST MILE 1.5
	TOLL BRIDGE SPECIAL ANALYSIS	






CU 04	DISCARD PERMITS BEARING	REVISION DATES (PRELIMINARY STAGE ONLY)
EA 043001	EARLIER REVISION DATES	

Donald Lee
REGISTERED ENGINEER - CIVIL
October 21, 1997


12-8-97
PLAYS APPROVAL DATE

REGISTERED PROFESSIONAL ENGINEER
DONALD LEE
No. 50978
Exp. 9-30-01
CIVIL
STATE OF CALIFORNIA

LEGEND

-  Indicates existing structures.
-  Indicates new structures.
-  Indicates new 1" ϕ high strength bolts in 1/4" ϕ hole.
-  Indicates existing rivets to be removed and replaced with new 1" ϕ high strength bolts in existing 1/16" ϕ hole.
-  Indicates approx. location of existing rivets

VA/E	Vertical Angle, Deck side and East side
VA/W	Vertical Angle, Deck side and West side
VA2E	Vertical Angle, Outside and East side
VA2W	Vertical Angle, Outside and West side
VCPI	Vertical Cover Plate, Deck side
VCP2	Vertical Cover Plate, Outside
VFP1	Vertical Filler Plate, Deck side
VFP2	Vertical Filler Plate, Outside
VSP1E	Vertical Splice Plate, Inside of VSP2E
VSP1W	Vertical Splice Plate, Inside of VSP2W
VSP2E	Vertical Splice Plate, Outside, East half
VSP2W	Vertical Splice Plate, Outside, West half
VPCPE	Vertical Perforated Cover Plate East side
VPCPW	Vertical Perforated Cover Plate West side

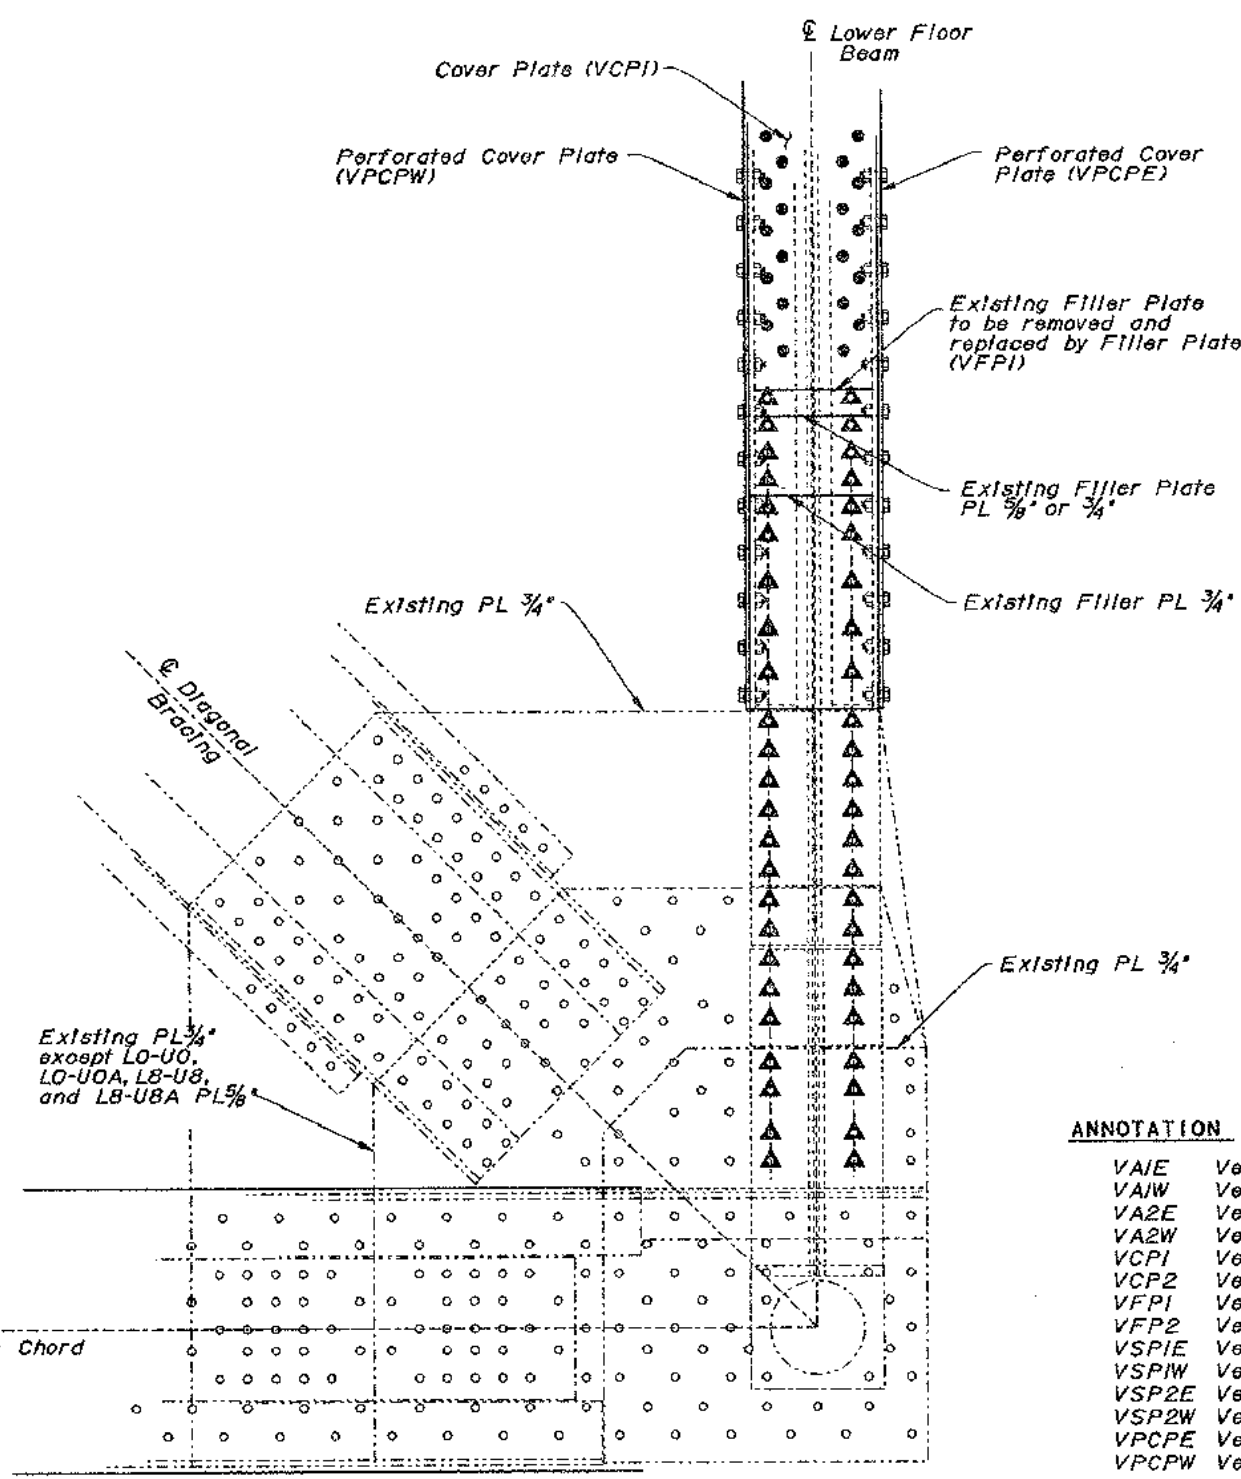

NOTE:
THE CONTRACTOR SHALL VERIFY ALL
CONTROLLING FIELD DIMENSIONS BEFORE
ORDERING OR FABRICATING ANY MATERIAL.

Vertical: $1' = 1'-0"$
Horizontal: $1' = 1'-0"$

BRIDGE NO.
33-0025
POST MILE
1.5

INTERIM SEISMIC RETROFIT PROJECT
EAST BAY 288 TRUSSES YERBA BUENA ISLAND
SAN FRANCISCO-OAKLAND BAY BRIDGE
MISCELLANEOUS DETAILS NO. 3

DISREGARD PRINTS BEARING EARLIER REVISION DATES	REVISION DATES (PRELIMINARY STAGE ONLY)							SHEET	OF
	5-18-91	5-22-91	5-30-91	6-5-91	6-28-91	6-29-91	9-22-91	29	36

DATE PLOTTED => 9-DEC-1997
TIME PLOTTED => 08:17

LEGEND

- Indicates existing structures.
- Indicates new structures.
- Indicates new 1" high strength bolts in 1/4" hole.
- Indicates existing rivets to be removed and replaced with new 1" high strength bolts in existing 1/4" hole.
- Indicates approx. location of existing rivets.
- Indicates Fastener Group

DIST.	COUNTY	ROUTE	POST MILES TOTAL PROJECT	SHEET NO.	TOTAL SHEETS
04	SF, Alameda	80	7.8/8.9, 0.0/1.1	98	205


REGISTERED ENGINEER - CIVIL

October 21, 1997


12-8-97

PLANS APPROVAL DATE

THE STATE OF CALIFORNIA OR ITS OFFICERS OR AGENTS SHALL NOT BE RESPONSIBLE FOR THE ACCURACY OR COMPLETENESS OF ELECTRONIC COPIES OF THIS PLAN SHEET.

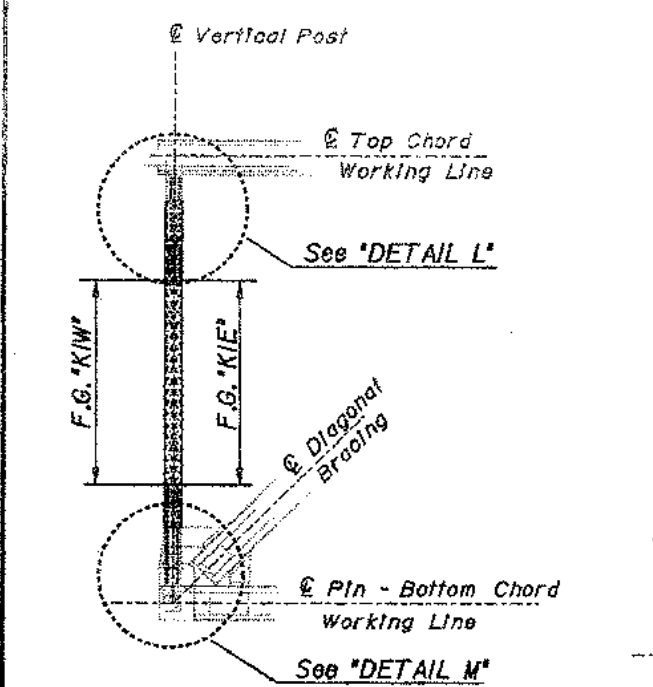


VIEW X-X
NO SCALE

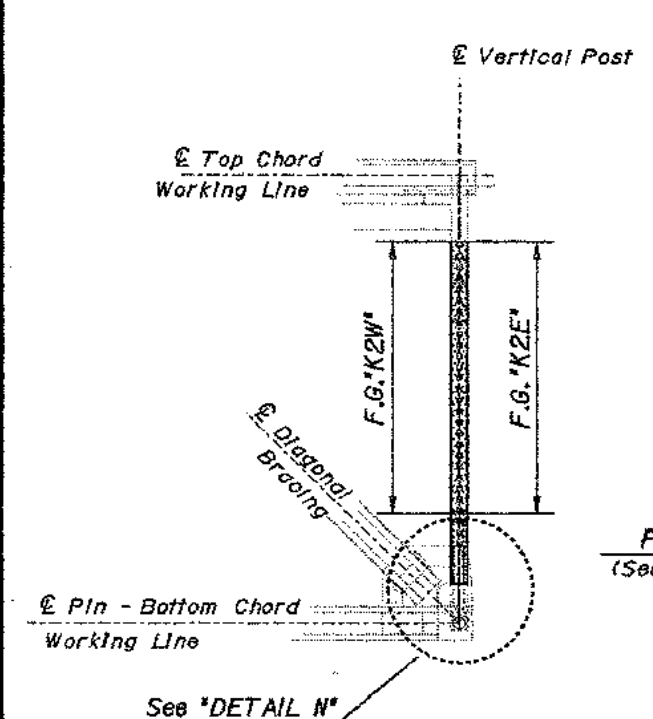


VIEW Y-Y
NO SCALE

NOTE:
THE CONTRACTOR SHALL VERIFY ALL CONTROLLING FIELD DIMENSIONS BEFORE ORDERING OR FABRICATING ANY MATERIAL.

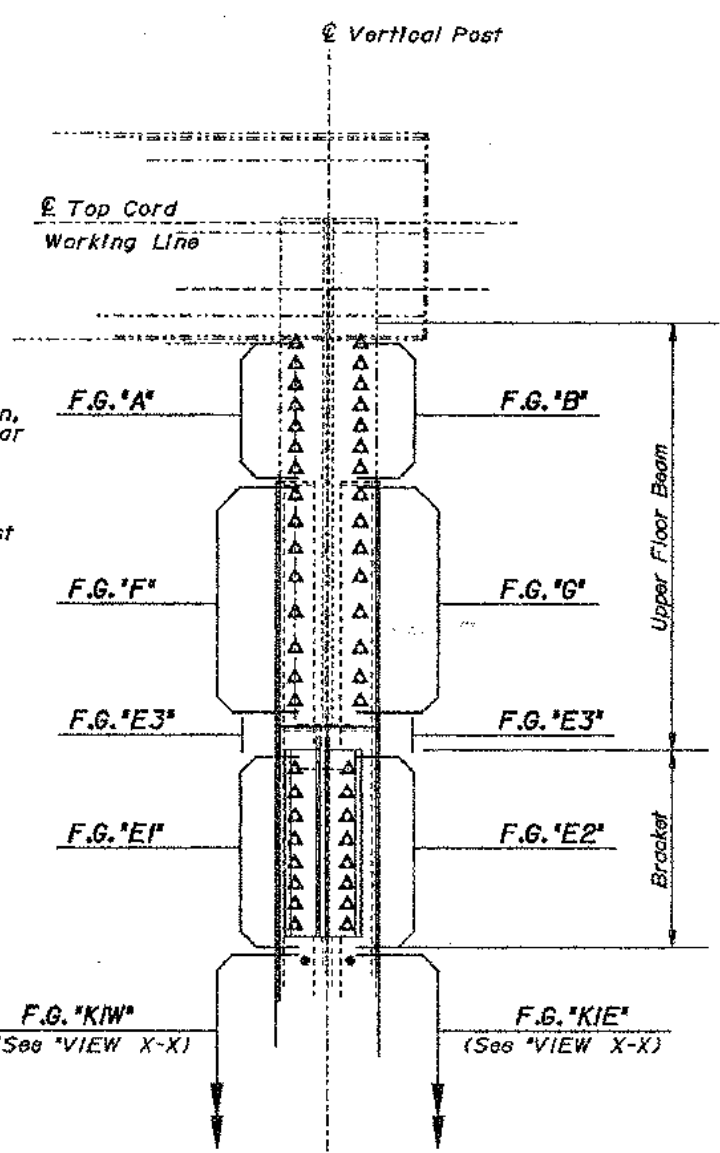


DETAIL L
3/4" = 1'-0"

Notes:
1. For locations of "VIEW X-X" and "VIEW Y-Y", see "VERTICAL MEMBER DETAIL NO.1 (NORTH)" and "VERTICAL MEMBER DETAIL NO.4 (SOUTH)" sheets.

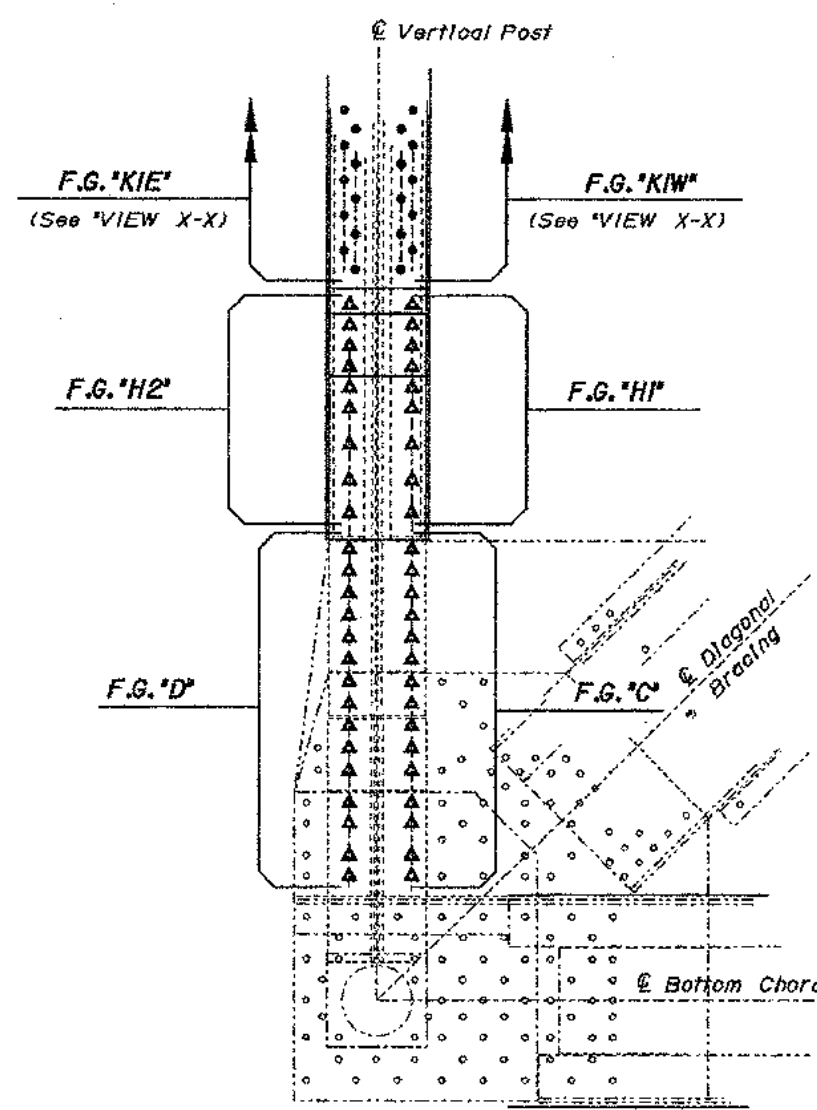

DETAIL M
3/4" = 1'-0"

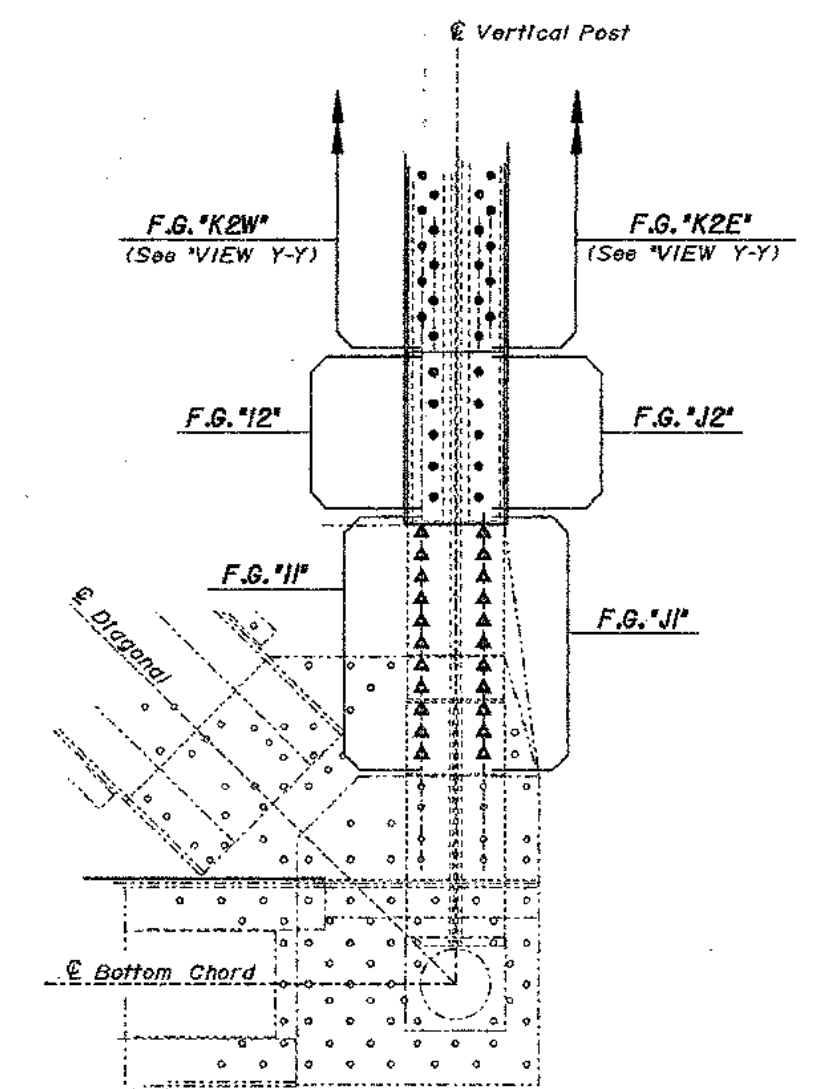


DETAIL N
3/4" = 1'-0"

INTERIM SEISMIC RETROFIT PROJECT	
EAST BAY 288 TRUSSES YERBA BUENA ISLAND	
SAN FRANCISCO-OAKLAND BAY BRIDGE	
MISCELLANEOUS DETAILS NO. 4	

DESIGN	BY E.A. Morris	5-97	CHECKED Don Lee	5-97
DETAILS	BY Ralph Nakagawa	5-97	CHECKED Don Lee	5-97
QUANTITIES	BY E.A. Morris	5-97	CHECKED Don Lee	5-97

STATE OF CALIFORNIA	DIVISION OF STRUCTURES
DEPARTMENT OF TRANSPORTATION	STRUCTURE DESIGN
	TOLL BRIDGE SPECIAL ANALYSIS

BRIDGE NO.	33-0025
POST MILE	1.5

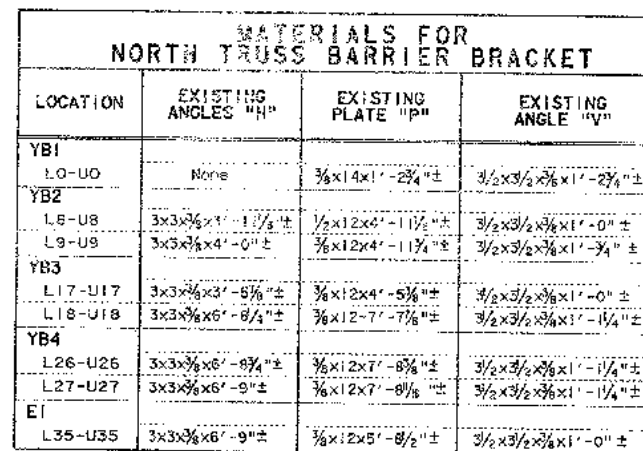

DIST.	COUNTY	ROUTE	TOTAL PROJECT POST MILES	SHEET NO.	TOTAL SHEETS
04	SCALA	80	7.8/8.9 0.2/1.1	99	205

[Signature]
 RES. STAFF ENGINEER CIVIL
 October 21, 1997


12-8-97
 CLASS APPROVAL DATE

SEAL: PROFESSIONAL ENGINEER
 JERRY KOUOJIN
 No. 50978
 Exp. 3-30-01
 CIVIL
 STATE OF CALIFORNIA

The State of California or its officers or agents shall not be responsible for the accuracy or completeness of electronic copies of this plan sheet.

LEGEND

- Indicates existing structures.
- indicates new structures.
- indicates new $\frac{1}{16}$ " high strength bolts in $\frac{1}{8}$ " hole.
- ▲ indicates existing $\frac{3}{4}$ " rivets to be removed and replaced with new $\frac{3}{4}$ " high strength bolts in existing $\frac{1}{8}$ " hole.
- indicates approx. location of existing rivets.
- ▨ indicates steel removal limit.

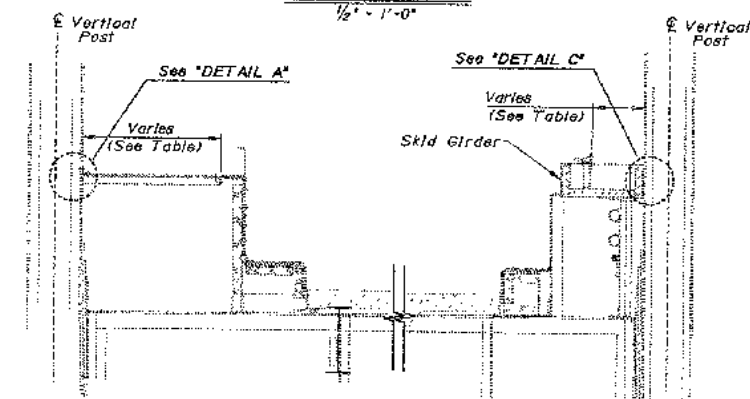

(NORTH DECK BARRIER)

(SOUTH DECK BARRIER)

ELEVATION VIEW

$$\frac{1}{2} \tau = f' \cdot Q^0$$

Notes:
For "DETAILS C & D" see
"BARRIER DETAILS NO. 2
through 4" sheets.

DESIGN	BY	5-97	CHECKED	5-97
	E.A. Morris		Don Lee	
DETAILS	BY	5-97	DRAWN	5-97
	Ralph Nakaoka		E.A. Morris	
QUANTITIES	BY	5-97	CHECKED	5-97
	Don Lee		E.A. Morris	

ORIGINAL SLIME BY INCHES
FOR REGULAR PLANS

STATE OF
CALIFORNIA
DEPARTMENT OF TRANSPORTATION

**DIVISION OF STRUCTURES
STRUCTURE DESIGN**

TOLL BRIDGE SPECIAL ANALYSIS

CU 04
15 243 6.1

BRIDGE NO.
33-0025

5 POSTAGE
1.5

DISREGARD PREVIOUS REVISIONS

INTERIM SEISMIC RETROFIT PROJECT

EAST BAY 288 TRUSSES YERBA BUENA ISLAND

SAN FRANCISCO-OAKLAND BAY BRIDGE

BARRIER DETAILS NO. 1

DISREGARD PRINTS OF ANY
EARLIER REVISION DATES

```


-> trbing
  extracted: 0000042

```


4751-20C-6 : K2 College 3178

LEGEND


- Indicates existing structures.
- Indicates new structures.
- Indicates new 3/4" high strength bolts in 1 1/2" hole.
- Indicates existing 3/4" rivets to be removed and replaced with new 3/4" high strength bolts in existing 1 1/2" hole.
- Indicates approx. location of existing rivets.
- Indicates steel removal limit.

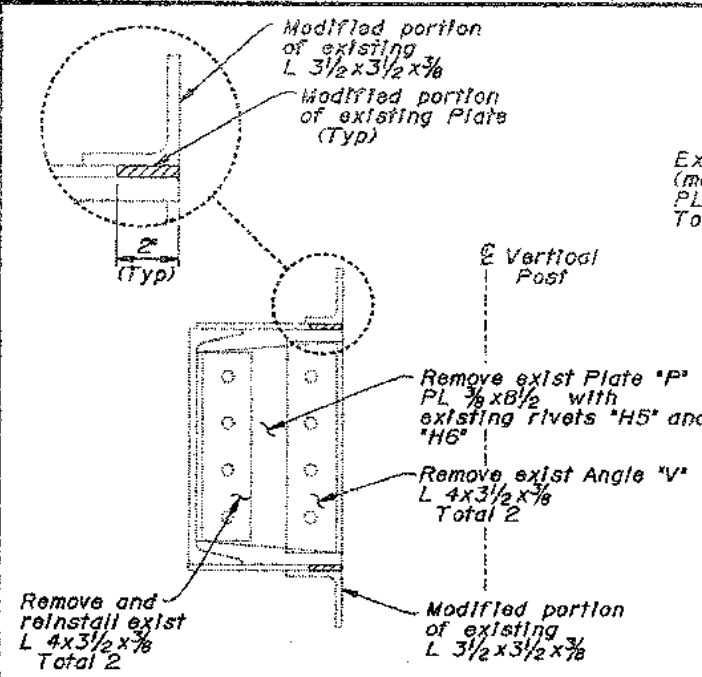


DETAIL C (YBI)

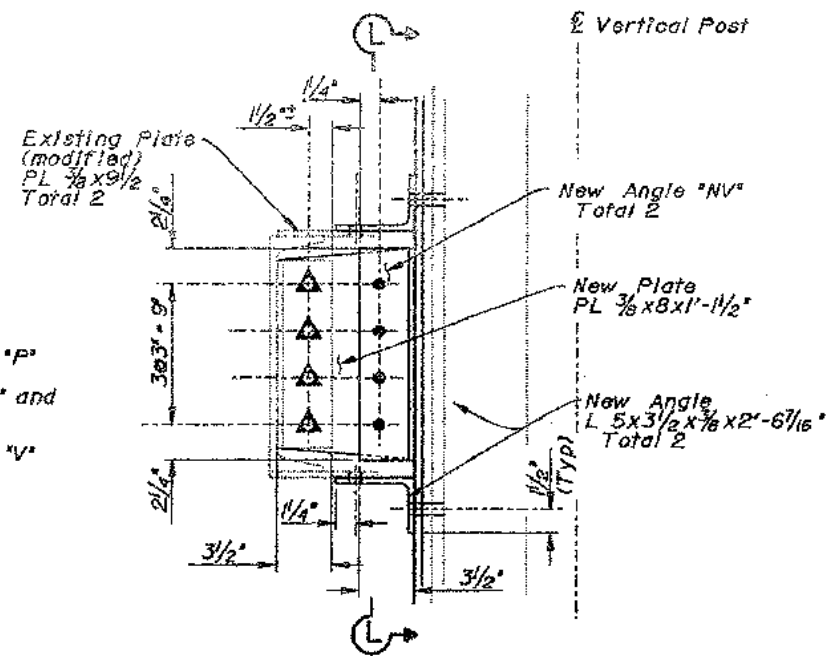


(RETROFITTED)

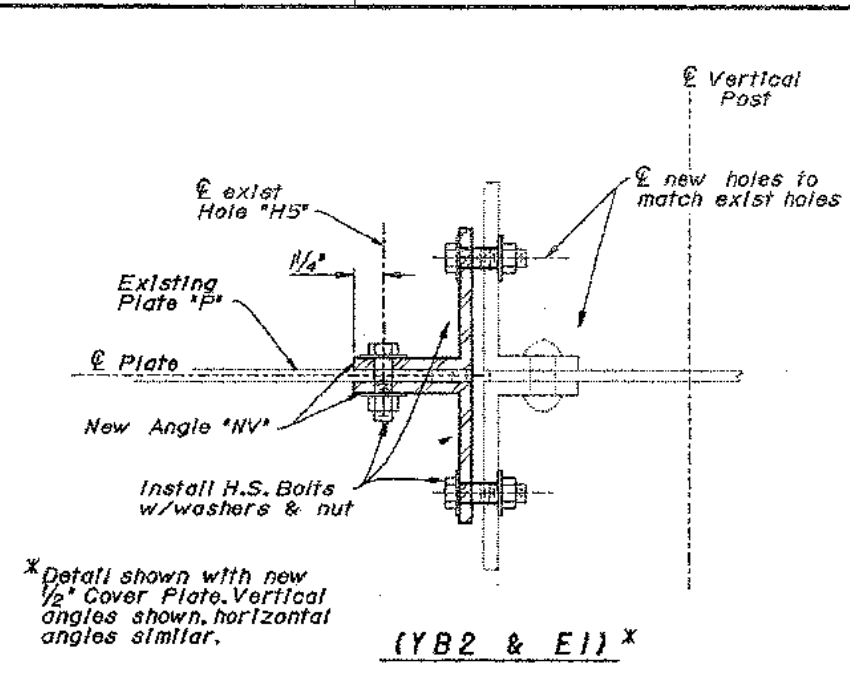


(YB2 & E1) *
DETAIL D

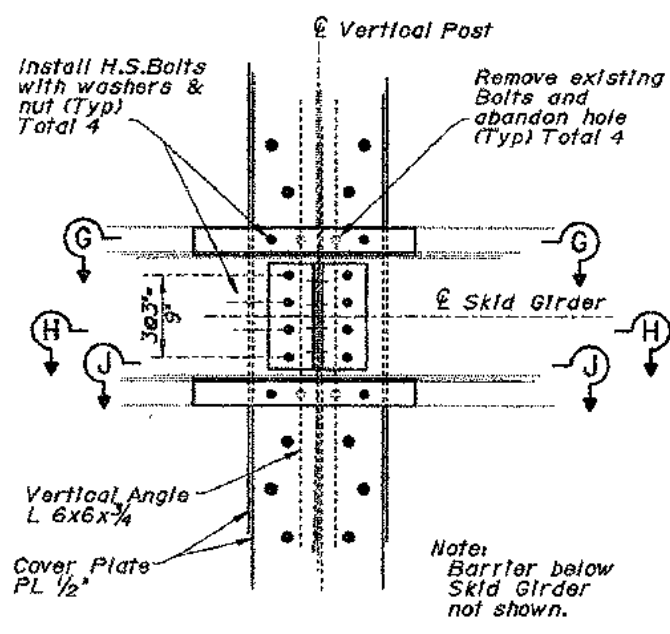


(SKID GIRDER AT YBI)
VIEW L-L

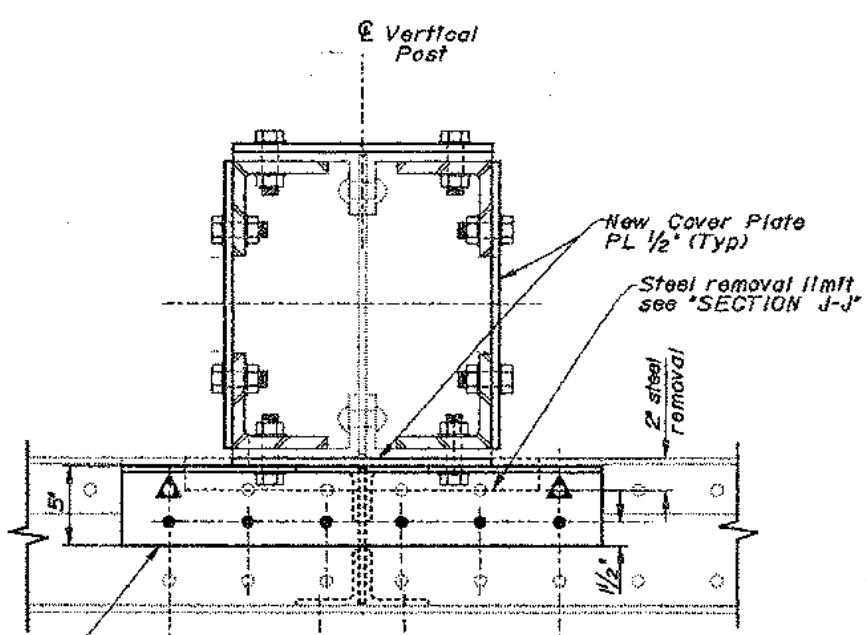

(RETROFITTED)
SECTION G-G

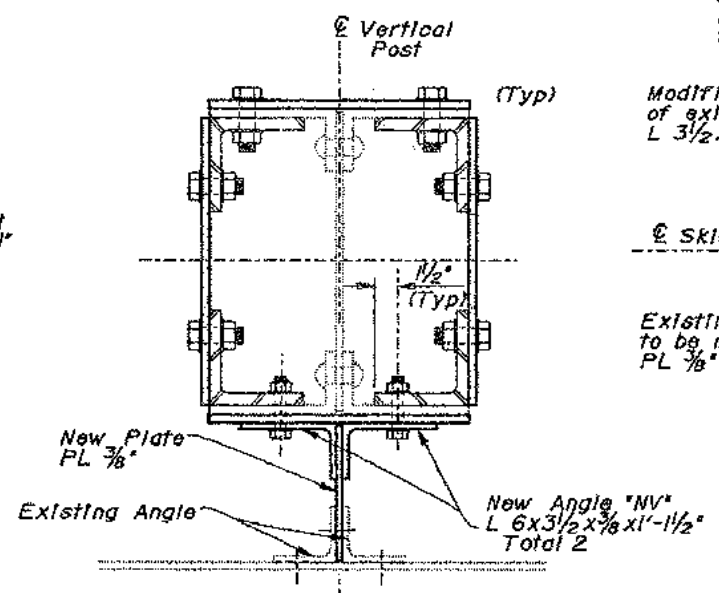

(RETROFITTED)
SECTION H-H

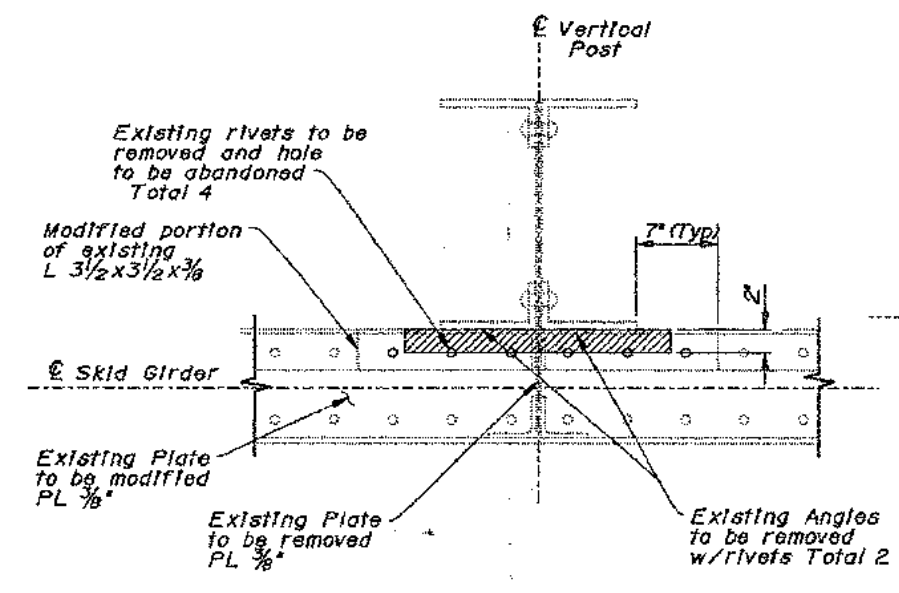

(STEEL REMOVAL)
SECTION J-J

Note: Bottom plate modification shown, top plate and angle similar.

NOTE:
THE CONTRACTOR SHALL VERIFY ALL CONTROLLING FIELD DIMENSIONS BEFORE ORDERING OR FABRICATING ANY MATERIAL.

DESIGN	BY E.A. Morris	5-97	CHECKED Don Lee	5-97
DETAILS	BY Ralph Nakagawa	5-97	CHECKED E.A. Morris	5-97
QUANTITIES	BY Don Lee	5-97	CHECKED E.A. Morris	5-97

STATE OF CALIFORNIA
DEPARTMENT OF TRANSPORTATION

DIVISION OF STRUCTURES
STRUCTURE DESIGN
TOLL BRIDGE SPECIAL ANALYSIS

BRIDGE NO.
33-0025
POST MILE
1.5

INTERIM SEISMIC RETROFIT PROJECT
EAST BAY 288 TRUSSES YERBA BUENA ISLAND
SAN FRANCISCO-OAKLAND BAY BRIDGE
BARRIER DETAILS NO. 2

INST.	COUNTY	ROUTE	POST MILES TOTAL PROJECT	SHEET NO.	TOTAL SHEETS
04	SF, Ala	80	7.8/8.9, 0.0/1.1	101	205

[Signature]
REGISTERED ENGINEER - CIVIL
October 24, 1997


12-8-97
PLANS APPROVAL DATE

REGISTERED PROFESSIONAL ENGINEER
DER-FU GONARD LEE
No. 50978
Exp. 9-30-01
CIVIL
STATE OF CALIFORNIA


The State of California or its officers or agents shall not be responsible for the accuracy or completeness of electronic copies of this plan sheet.

LEGEND


- Indicates existing structures.
- Indicates new structures.
- Indicates new $\frac{3}{4}$ " ϕ high strength bolts in $\frac{13}{16}$ " ϕ hole.
- ▲ Indicates existing $\frac{3}{4}$ " ϕ rivets to be removed and replaced with new $\frac{3}{4}$ " ϕ high strength bolts in existing $\frac{13}{16}$ " ϕ hole.
- Indicates approx. location of existing rivets.
- ▨ Indicates steel removal limit.

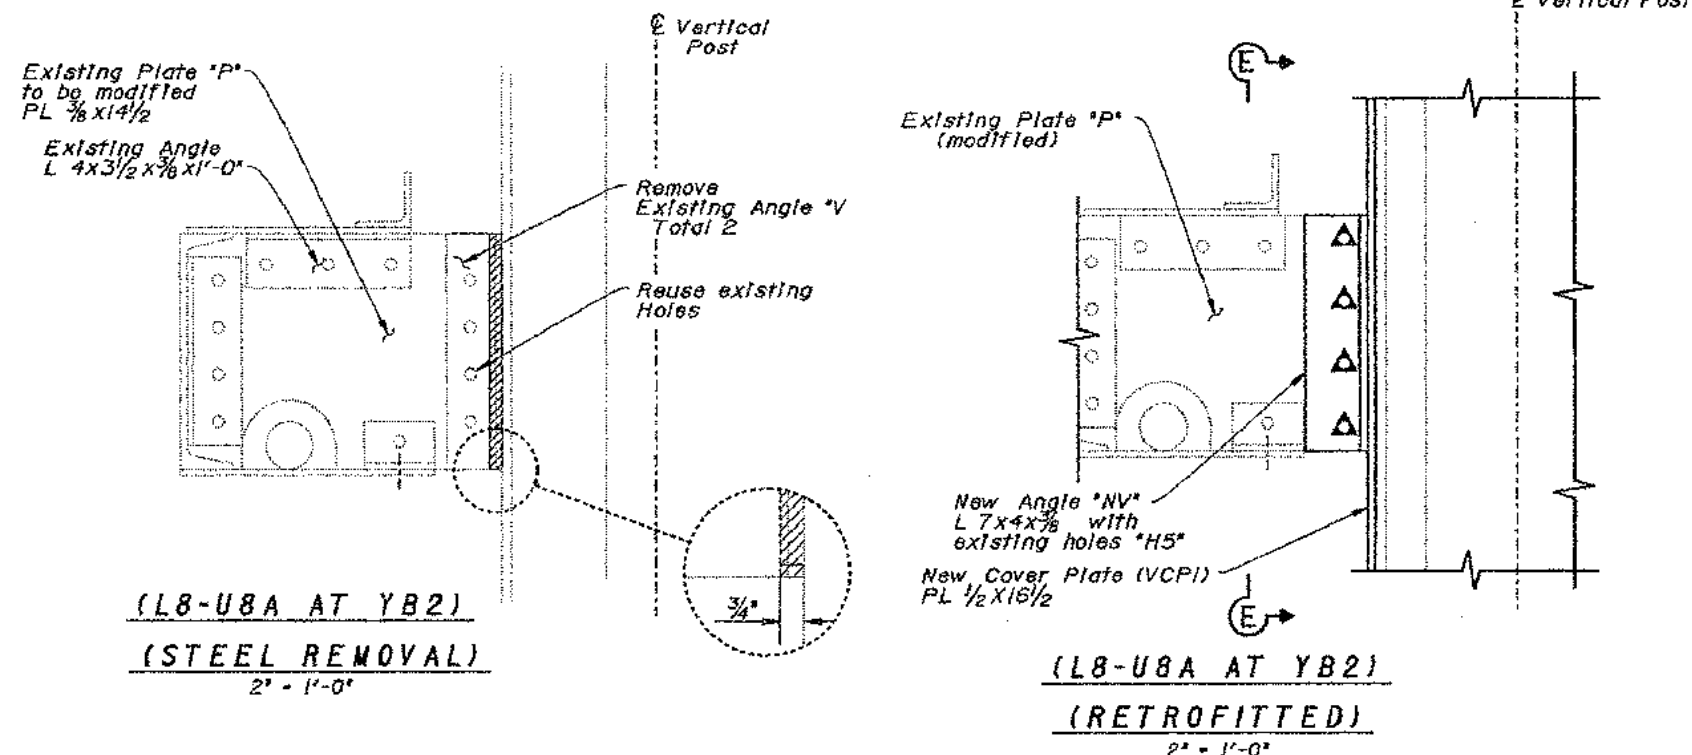


D E T A I L C

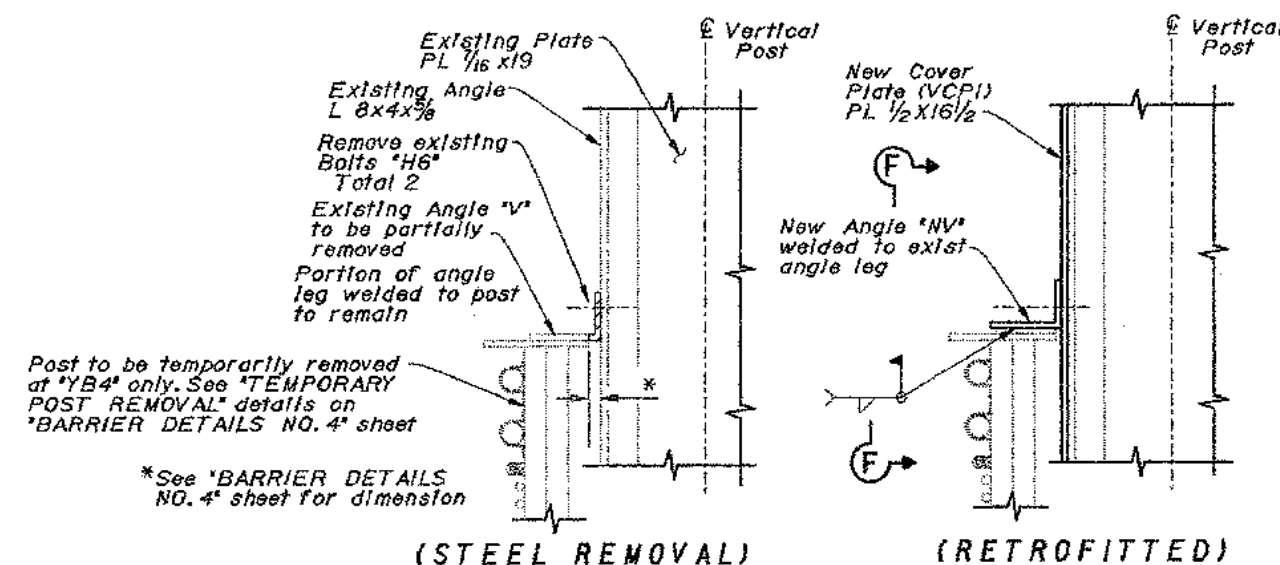

(YB3 & YB4)
DETAIL C
(1/2" = 1'-0")

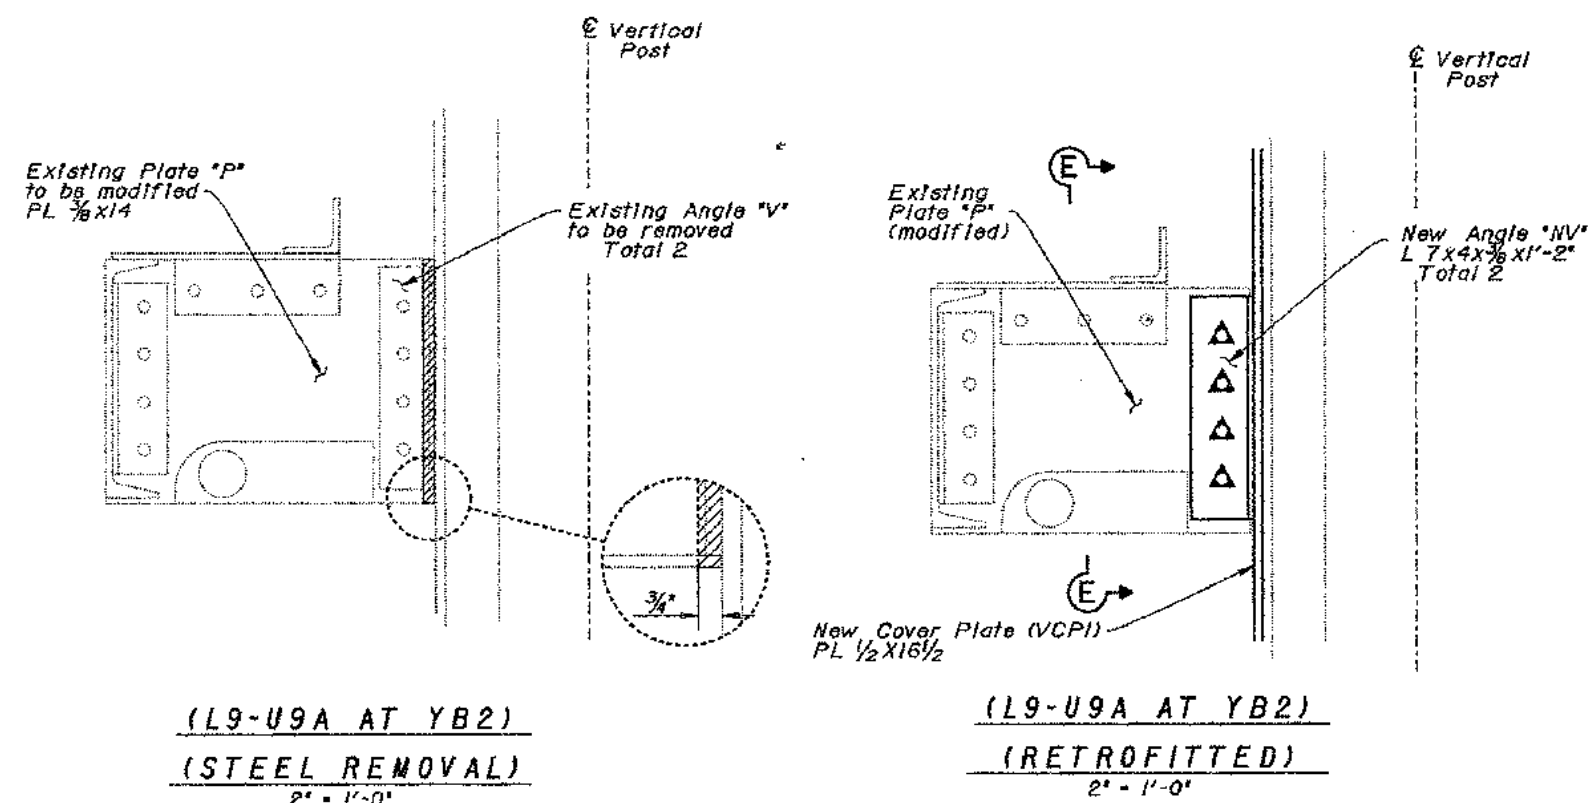

DET A I L C

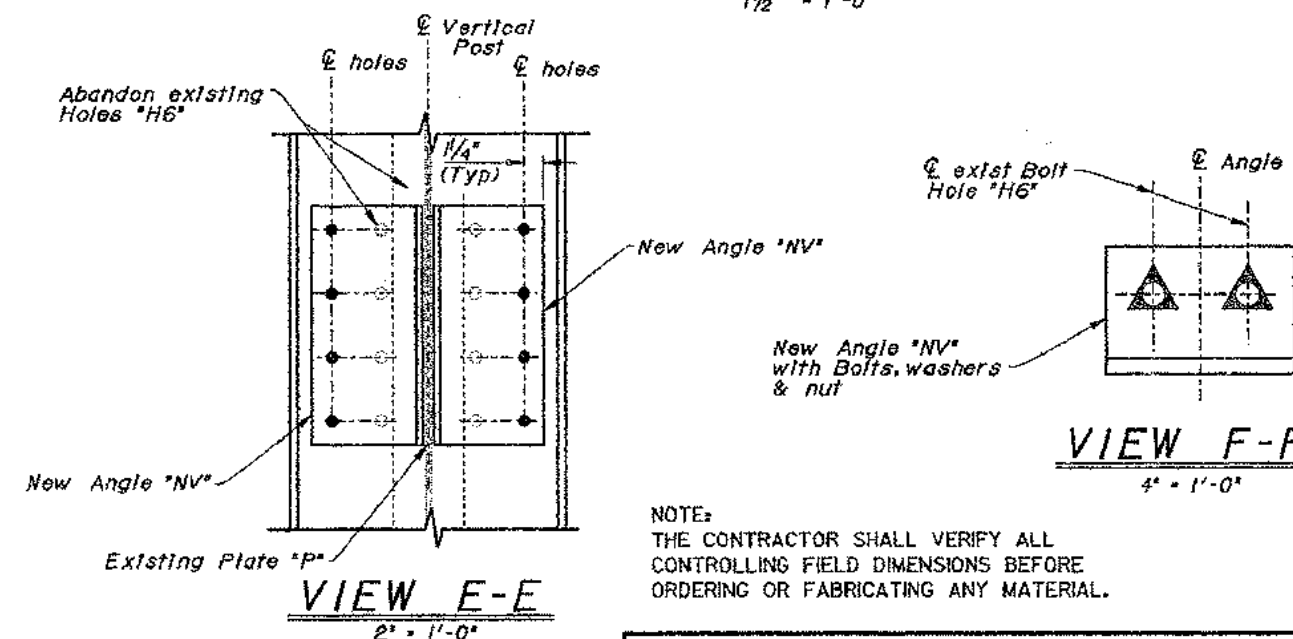

NOTE:
THE CONTRACTOR SHALL VERIFY ALL
CONTROLLING FIELD DIMENSIONS BEFORE
ORDERING OR FABRICATING ANY MATERIAL.

INTERIM SEISMIC RETROFIT PROJECT
EAST BAY 288 TRUSSES YERBA BUENA ISLAND

SAN FRANCISCO-OAKLAND BAY BRIDGE
BARRIER DETAILS NO. 3

DESIGN	BY E.A. Morris	5-97	CHECKED Don Lee	5-9
DETAILS	BY Ralph Nakaoka	5-97	CHECKED E.A. Morris	5-9
QUANTITIES	BY Don Lee	5-97	CHECKED E.A. Morris	5-9

STATE OF
CALIFORNIA
DEPARTMENT OF TRANSPORTATION

**DIVISION OF STRUCTURES
STRUCTURE DESIGN
TOLL BRIDGE SPECIAL ANALYSIS**

CU 04
EA 0434J}

	REVISION DATES (PRELIMINARY STAGE ONLY)						SHEET	OF
DISECARD PRINTS BEARING EARLIER REVISION DATES →	5-0-95	5-2-97	6-30-98	7-2-99	10-2-99		33	36

DIST.	COUNTY	ROUTE	POST MILES TOTAL PROJECT	SHEET NO.	TOTAL SHEETS
04	SF, Alameda	80	7.8/8.9, 0.0/1.1	102	205

REGISTERED ENGINEER - CIVIL
October 24, 1997

12-8-97
PLANS APPROVAL DATE

The State of California or its officers or agents shall not be responsible for the accuracy or completeness of electronic copies of this plan sheet.

LEGEND

Indicates existing structures.

Indicates new structures.


Indicates new 1" high strength bolts.

Indicates existing 1" rivets to be removed and replaced with new 1" high strength bolts.

Indicates approx. location of existing rivets.

Indicates steel removal limit.

F.S. Far Side
N.S. Near Side

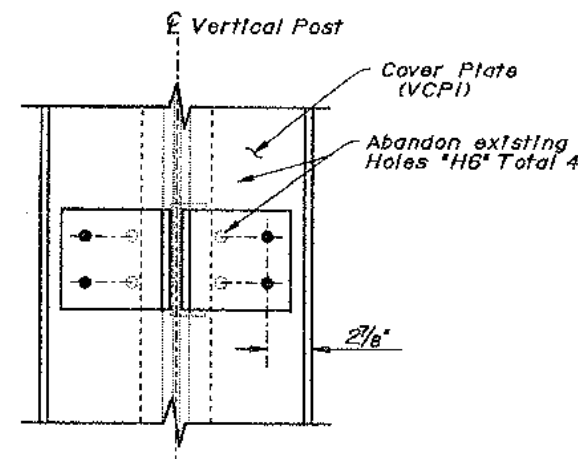


VIEW H-H
2' - 1'-0"

MATERIALS FOR SOUTH TRUSS BARRIER BRACKET					
LOCATION	EXISTING RIVETS/BOLTS ON PLATE "H5"	EXISTING RIVETS/BOLTS ON POST "H6"	EXISTING PLATE "P"	EXISTING ANGLE "V"	NEW ANGLE "NV"
YB1 LO-UOA	4-3/4" Rivets*	8-3/4" Rivets	3/8x8 1/2x1' - 1 1/2"±	4x3 1/2x3/8x1' - 1 1/2"	2-L 6x3 1/2x3/8x1' - 1 1/2"
YB2 L8-U8A	4-3/4" Rivets**	8-1" Rivets	3/8x14 1/2x1' - 7"±	2-L 4x3 1/2x3/8x1' - 2 1/2"±	2-L 7x4x3/8x1' - 2 1/2"
L9-U9A	4 Bolts**	8-1" Rivets	3/8x14x1' - 9"±	2-L 5x3 1/2x3/8x1' - 2"±	2-L 7x4x3/8x1' - 2"
YB3 L17-U17A	None, see Note 3	2 Bolts	None	6x4x3/8x0' - 6"±	6x4x3/8x0' - 6"
L18-U18A	None, see Note 3	2 Bolts	None	6x4x3/8x0' - 6"±	6x4x3/8x0' - 6"
YB4 L26-U26A	None, see Note 4	2 Bolts	None	6x4x3/8x0' - 6"±	6x4x3/8x0' - 6"
L27-U27A	None, see Note 4	2 Bolts	None	6x4x3/8x0' - 6"±	6x4x3/8x0' - 6"
EI L35-U35A	4-1" Rivets	4-1" Rivets	C8x18.75x2' - 2"±	F.S. 6x6x3/8x0' - 6 1/2"± N.S. 6x3 1/2x3/8x0' - 6 1/2"±	F.S. 8x8x1/2x0' - 6 1/2"± N.S. 8x8x1/2x0' - 6 1/2"±

*See Note 1
**See Note 2

Notes:

1. For barrier temporary removal and replacement details at YB1, see "BARRIER DETAILS NO. 2" sheet.
2. For barrier temporary removal and replacement details at YB2, see "BARRIER DETAILS NO. 2" and "Barrier Details No. 3" sheets.
3. For barrier temporary removal and replacement details at YB3, see "BARRIER DETAILS NO. 3" sheet. Utility box above skid girder not shown, see Road Plans.
4. For barrier temporary removal and replacement details at YB4, see "BARRIER DETAILS NO. 3" sheet.
5. All rivets to be replaced with same size H.S. Bolts.

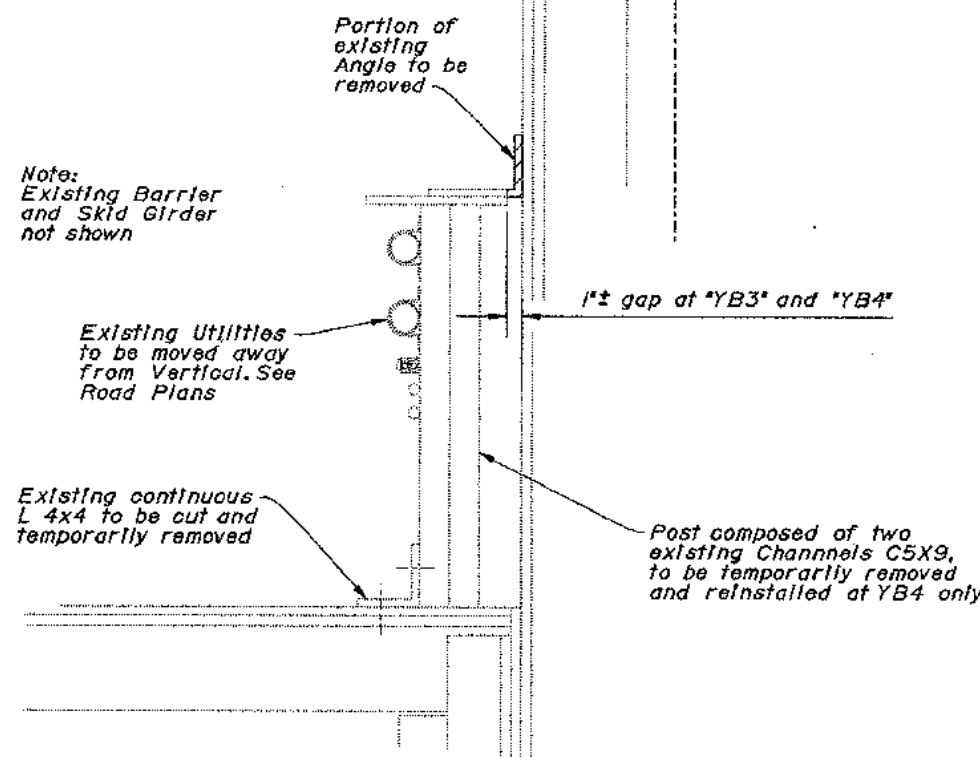

Note:
Existing Barrier and Skid Girder not shown

Existing Utilities to be moved away from Vertical. See Road Plans

Existing continuous L 4x4 to be cut and temporarily removed

Post composed of two existing Channels C5X9, to be temporarily removed and reinstalled at YB4 only

1"± gap at "YB3" and "YB4"


Existing Angle L 4x3 1/2x3/8x1' - 3"

Existing Channel C 8x18.75x2' - 2"

Remove exist angle L 6x3 1/2 (N.S.) L 6x6 (F.S.) and rivets

3/4" to be removed

(EI)
(STEEL REMOVAL)
DETAIL C
2' - 1'-0"

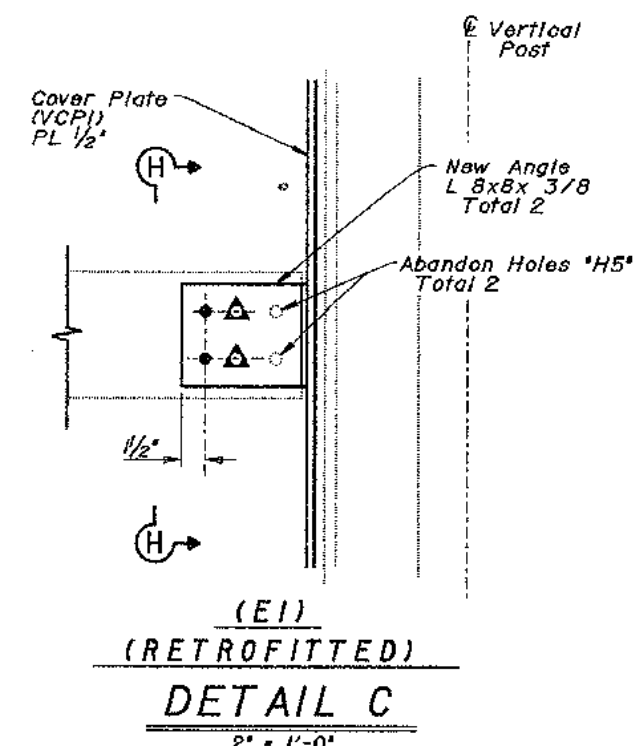

(EI)
(RETROFITTED)
DETAIL C
2' - 1'-0"

(L26-U26A AT YB4 ONLY)
(STEEL REMOVAL)
TEMPORARY POST REMOVAL
2' - 1'-0"

NOTE:
THE CONTRACTOR SHALL VERIFY ALL CONTROLLING FIELD DIMENSIONS BEFORE ORDERING OR FABRICATING ANY MATERIAL.

DESIGN	BY E.A. Morris	5-97	CHECKED Don Lee	6-97
DETAILS	BY Ralph Nakagawa	5-97	CHECKED E.A. Morris	5-97
QUANTITIES	BY Don Lee	5-97	CHECKED E.A. Morris	5-97

STATE OF CALIFORNIA
DEPARTMENT OF TRANSPORTATION

DIVISION OF STRUCTURES
STRUCTURE DESIGN
TOLL BRIDGE SPECIAL ANALYSIS

BRIDGE NO. 33-0025
POST MILE 1.5

INTERIM SEISMIC RETROFIT PROJECT
EAST BAY 288 TRUSSES YERBA BUENA ISLAND
SAN FRANCISCO-OAKLAND BAY BRIDGE
BARRIER DETAILS NO. 4


DIST.	COUNTY	ROUTE	POST MILES TOTAL PROJECT	SHEET NO.	TOTAL SHEETS
04	SF, Alameda	80	7.8/8.9, 0.0/1.1	103	205

REGISTERED ENGINEER - CIVIL
 October 24, 1997
 12-8-97
 PLANS APPROVAL DATE

The State of California or its officers or agents shall not be responsible for the accuracy or completeness of electronic copies of this plan sheet.

LEGEND


- Indicates Existing Structure
- Indicates New Construction

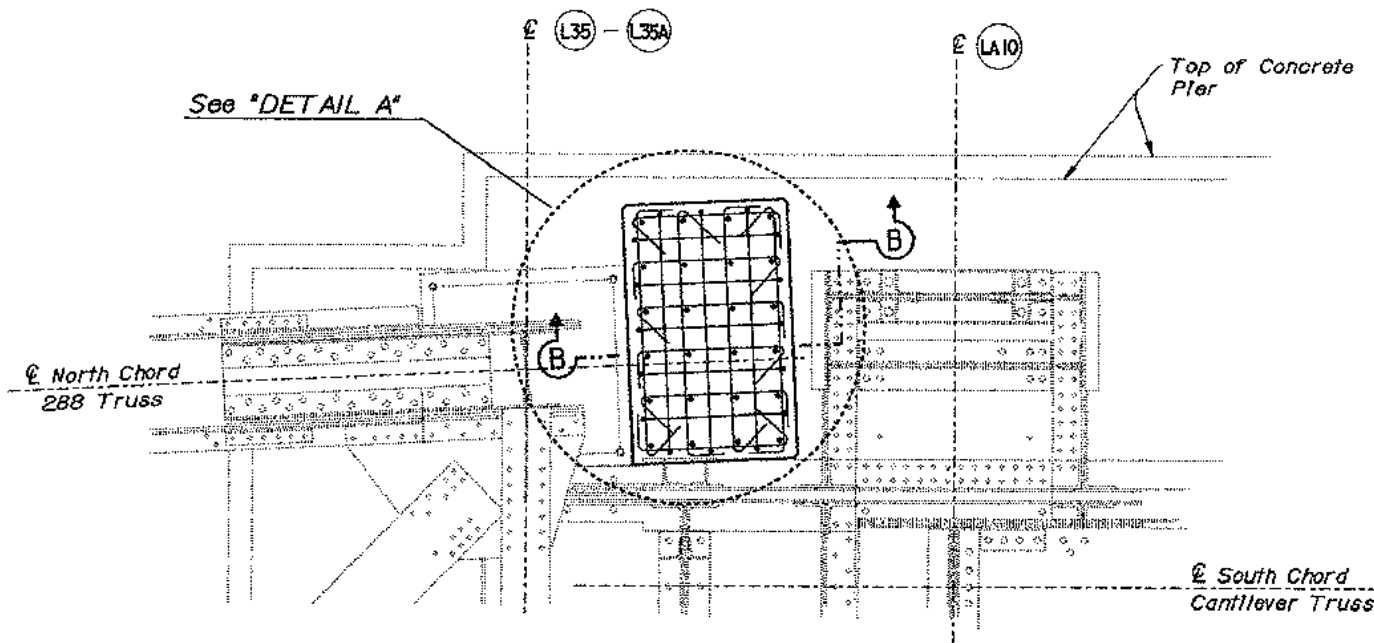

(PIER EI (NORTH))

PLAN


1/2" = 1'-0"

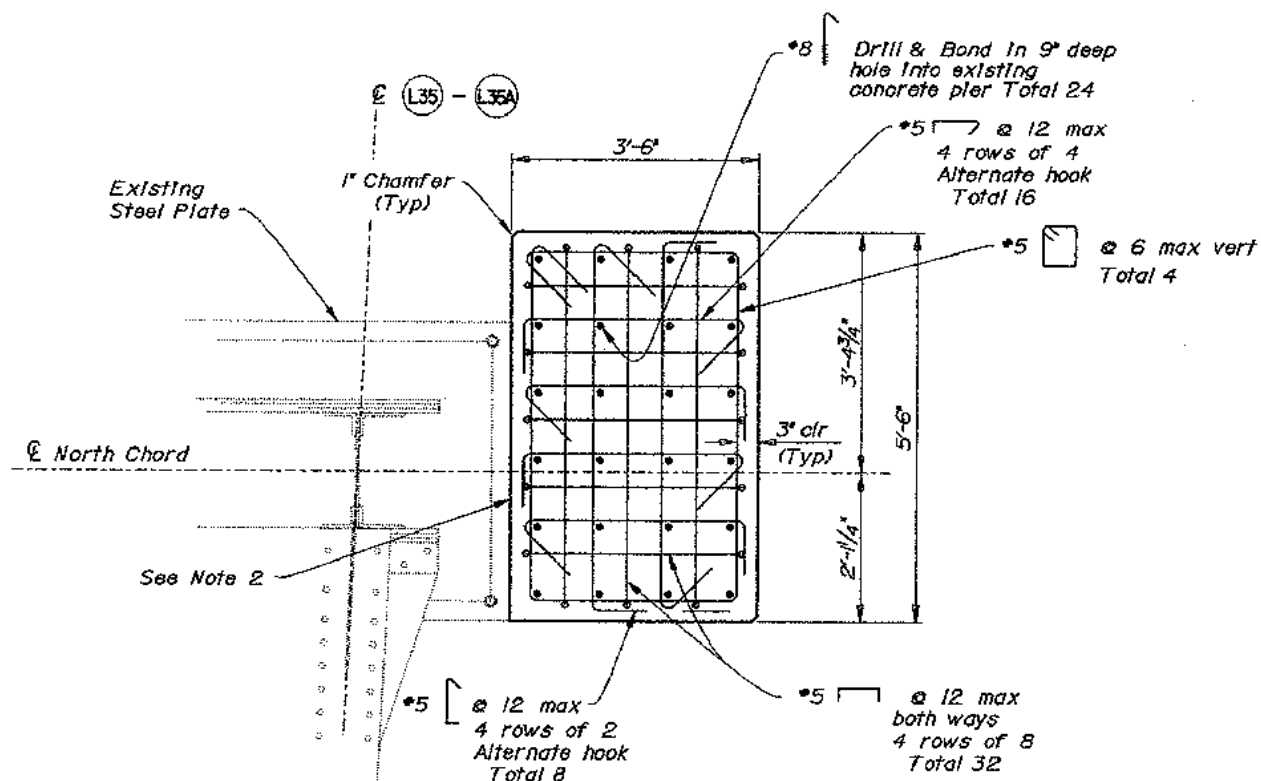

DETAIL A

3/4" = 1'-0"

NOTE:
THE CONTRACTOR SHALL VERIFY ALL CONTROLLING FIELD DIMENSIONS BEFORE ORDERING OR FABRICATING ANY MATERIAL.

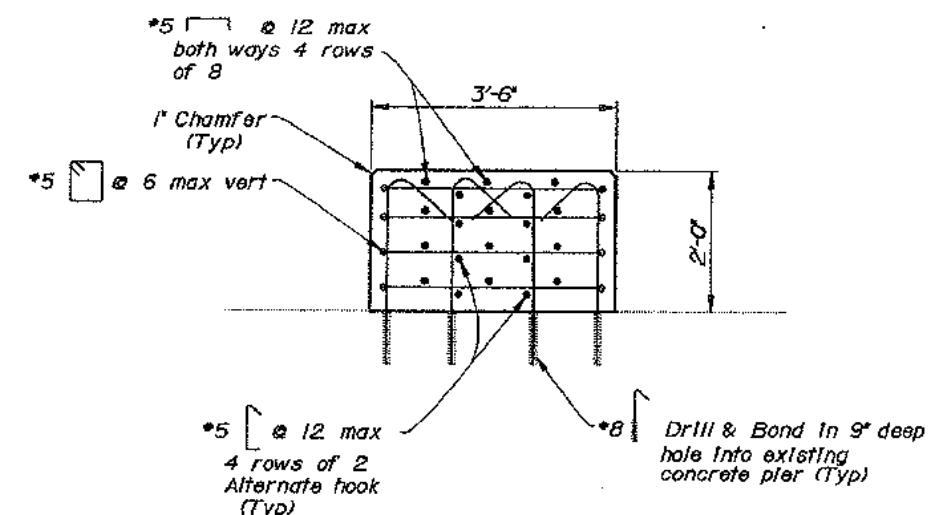


SECTION B-B

3/4" = 1'-0"

Notes:

- Locations of drilled dowel holes for #8 dowels are approximate. Prior to drilling holes in concrete the Contractor shall locate all reinforcing steel and adjust the location of the holes to clear all reinforcing bars. Final hole locations are subject to the approval of the Engineer. The total number of dowels shall remain the same.
- One side of the concrete bolster shall be placed flush against the existing steel shoe jacket.

DESIGN BY Don Lee 10-97 CHECKED E.A. Morris 10-97 DETAILS BY Ralph Nakagawa 10-97 CHECKED Don Lee 10-97 QUANTITIES BY E.A. Morris 10-97 CHECKED Don Lee 10-97				STATE OF CALIFORNIA DEPARTMENT OF TRANSPORTATION	DIVISION OF STRUCTURES STRUCTURE DESIGN TOLL BRIDGE SPECIAL ANALYSIS	BRIDGE NO. 33-0025 POST MILE 1.5 CU 04 EA 043001	INTERIM SEISMIC RETROFIT PROJECT EAST BAY 288 TRUSSES YERBA BUENA ISLAND SAN FRANCISCO-OAKLAND BAY BRIDGE PIER EI ANCHORAGE DETAILS NO. 1		DISREGARD PRINTS BEARING EARLIER REVISION DATES REVISION DATES (PRELIMINARY SCALE ONLY) 10-97 11-97 12-97 1-98 2-98 3-98 4-98 5-98 6-98 7-98 8-98 9-98 10-98 11-98 12-98 1-99 2-99 3-99 4-99 5-99 6-99 7-99 8-99 9-99 10-99 11-99 12-99 1-00 2-00 3-00 4-00 5-00 6-00 7-00 8-00 9-00 10-00 11-00 12-00 1-01 2-01 3-01 4-01 5-01 6-01 7-01 8-01 9-01 10-01 11-01 12-01 1-02 2-02 3-02 4-02 5-02 6-02 7-02 8-02 9-02 10-02 11-02 12-02 1-03 2-03 3-03 4-03 5-03 6-03 7-03 8-03 9-03 10-03 11-03 12-03 1-04 2-04 3-04 4-04 5-04 6-04 7-04 8-04 9-04 10-04 11-04 12-04 1-05 2-05 3-05 4-05 5-05 6-05 7-05 8-05 9-05 10-05 11-05 12-05 1-06 2-06 3-06 4-06 5-06 6-06 7-06 8-06 9-06 10-06 11-06 12-06 1-07 2-07 3-07 4-07 5-07 6-07 7-07 8-07 9-07 10-07 11-07 12-07 1-08 2-08 3-08 4-08 5-08 6-08 7-08 8-08 9-08 10-08 11-08 12-08 1-09 2-09 3-09 4-09 5-09 6-09 7-09 8-09 9-09 10-09 11-09 12-09 1-10 2-10 3-10 4-10 5-10 6-10 7-10 8-10 9-10 10-10 11-10 12-10 1-11 2-11 3-11 4-11 5-11 6-11 7-11 8-11 9-11 10-11 11-11 12-11 1-12 2-12 3-12 4-12 5-12 6-12 7-12 8-12 9-12 10-12 11-12 12-12 1-13 2-13 3-13 4-13 5-13 6-13 7-13 8-13 9-13 10-13 11-13 12-13 1-14 2-14 3-14 4-14 5-14 6-14 7-14 8-14 9-14 10-14 11-14 12-14 1-15 2-15 3-15 4-15 5-15 6-15 7-15 8-15 9-15 10-15 11-15 12-15 1-16 2-16 3-16 4-16 5-16 6-16 7-16 8-16 9-16 10-16 11-16 12-16 1-17 2-17 3-17 4-17 5-17 6-17 7-17 8-17 9-17 10-17 11-17 12-17 1-18 2-18 3-18 4-18 5-18 6-18 7-18 8-18 9-18 10-18 11-18 12-18 1-19 2-19 3-19 4-19 5-19 6-19 7-19 8-19 9-19 10-19 11-19 12-19 1-20 2-20 3-20 4-20 5-20 6-20 7-20 8-20 9-20 10-20 11-20 12-20 1-21 2-21 3-21 4-21 5-21 6-21 7-21 8-21 9-21 10-21 11-21 12-21 1-22 2-22 3-22 4-22 5-22 6-22 7-22 8-22 9-22 10-22 11-22 12-22 1-23 2-23 3-23 4-23 5-23 6-23 7-23 8-23 9-23 10-23 11-23 12-23 1-24 2-24 3-24 4-24 5-24 6-24 7-24 8-24 9-24 10-24 11-24 12-24 1-25 2-25 3-25 4-25 5-25 6-25 7-25 8-25 9-25 10-25 11-25 12-25 1-26 2-26 3-26 4-26 5-26 6-26 7-26 8-26 9-26 10-26 11-26 12-26 1-27 2-27 3-27 4-27 5-27 6-27 7-27 8-27 9-27 10-27 11-27 12-27 1-28 2-28 3-28 4-28 5-28 6-28 7-28 8-28 9-28 10-28 11-28 12-28 1-29 2-29 3-29 4-29 5-29 6-29 7-29 8-29 9-29 10-29 11-29 12-29 1-30 2-30 3-30 4-30 5-30 6-30 7-30 8-30 9-30 10-30 11-30 12-30 1-31 2-31 3-31 4-31 5-31 6-31 7-31 8-31 9-31 10-31 11-31 12-31 1-32 2-32 3-32 4-32 5-32 6-32 7-32 8-32 9-32 10-32 11-32 12-32 1-33 2-33 3-33 4-33 5-33 6-33 7-33 8-33 9-33 10-33 11-33 12-33 1-34 2-34 3-34 4-34 5-34 6-34 7-34 8-34 9-34 10-34 11-34 12-34 1-35 2-35 3-35 4-35 5-35 6-35 7-35 8-35 9-35 10-35 11-35 12-35 1-36 2-36 3-36 4-36 5-36 6-36 7-36 8-36 9-36 10-36 11-36 12-36 1-37 2-37 3-37 4-37 5-37 6-37 7-37 8-37 9-37 10-37 11-37 12-37 1-38 2-38 3-38 4-38 5-38 6-38 7-38 8-38 9-38 10-38 11-38 12-38 1-39 2-39 3-39 4-39 5-39 6-39 7-39 8-39 9-39 10-39 11-39 12-39 1-40 2-40 3-40 4-40 5-40 6-40 7-40 8-40 9-40 10-40 11-40 12-40 1-41 2-41 3-41 4-41 5-41 6-41 7-41 8-41 9-41 10-41 11-41 12-41 1-42 2-42 3-42 4-42 5-42 6-42 7-42 8-42 9-42 10-42 11-42 12-42 1-43 2-43 3-43 4-43 5-43 6-43 7-43 8-43 9-43 10-43 11-43 12-43 1-44 2-44 3-44 4-44 5-44 6-44 7-44 8-44 9-44 10-44 11-44 12-44 1-45 2-45 3-45 4-45 5-45 6-45 7-45 8-45 9-45 10-45 11-45 12-45 1-46 2-46 3-46 4-46 5-46 6-46 7-46 8-46 9-46 10-46 11-46 12-46 1-47 2-47 3-47 4-47 5-47 6-47 7-47 8-47 9-47 10-47 11-47 12-47 1-48 2-48 3-48 4-48 5-48 6-48 7-48 8-48 9-48 10-48 11-48 12-48 1-49 2-49 3-49 4-49 5-49 6-49 7-49 8-49 9-49 10-49 11-49 12-49 1-50 2-50 3-50 4-50 5-50 6-50 7-50 8-50 9-50 10-50 11-50 12-50 1-51 2-51 3-51 4-51 5-51 6-51 7-51 8-51 9-51 10-51 11-51 12-51 1-52 2-52 3-52 4-52 5-52 6-52 7-52 8-52 9-52 10-52 11-52 12-52 1-53 2-53 3-53 4-53 5-53 6-53 7-53 8-53 9-53 10-53 11-53 12-53 1-54 2-54 3-54 4-54 5-54 6-54 7-54 8-54 9-54 10-54 11-54 12-54 1-55 2-55 3-55 4-55 5-55 6-55 7-55 8-55 9-55 10-55 11-55 12-55 1-56 2-56 3-56 4-56 5-56 6-56 7-56 8-56 9-56 10-56 11-56 12-56 1-57 2-57 3-57 4-57 5-57 6-57 7-57 8-57 9-57 10-57 11-57 12-57 1-58 2-58 3-58 4-58 5-58 6-58 7-58 8-58 9-58 10-58 11-58 12-58 1-59 2-59 3-59 4-59 5-59 6-59 7-59 8-59 9-59 10-59 11-59 12-59 1-60 2-60 3-60 4-60 5-60 6-60 7-60 8-60 9-60 10-60 11-60 12-60 1-61 2-61 3-61 4-61 5-61 6-61 7-61 8-61 9-61 10-61 11-61 12-61 1-62 2-62 3-62 4-62 5-62 6-62 7-62 8-62 9-62 10-62 11-62 12-62 1-63 2-63 3-63 4-63 5-63 6-63 7-63 8-63 9-63 10-63 11-63 12-63 1-64 2-64 3-64 4-64 5-64 6-64 7-64 8-64 9-64 10-64 11-64 12-64 1-65 2-65 3-65 4-65 5-65 6-65 7-65 8-65 9-65 10-65 11-65 12-65 1-66 2-66 3-66 4-66 5-66 6-66 7-66 8-66 9-66 10-66 11-66 12-66 1-67 2-67 3-67 4-67 5-67 6-67 7-67 8-67 9-67 10-67 11-67 12-67 1-68 2-68 3-68 4-68 5-68 6-68 7-68 8-68 9-68 10-68 11-68 12-68 1-69 2-69 3-69 4-69 5-69 6-69 7-69 8-69 9-69 10-69 11-69 12-69 1-70 2-70 3-70 4-70 5-70 6-70 7-70 8-70 9-70 10-70 11-70 12-70 1-71 2-71 3-71 4-71 5-71 6-71 7-71 8-71 9-71 10-71 11-71 12-71 1-72 2-72 3-72 4-72 5-72 6-72 7-72 8-72 9-72 10-72 11-72 12-72 1-73 2-73 3-73 4-73 5-73 6-73 7-73 8-73 9-73 10-73 11-73 12-73 1-74 2-74 3-74 4-74 5-74 6-74 7-74 8-74 9-74 10-74 11-74 12-74 1-75 2-75 3-75 4-75 5-75 6-75 7-75 8-75 9-75 10-75 11-75 12-75 1-76 2-76 3-76 4-76 5-76 6-76 7-76 8-76 9-76 10-76 11-76 12-76 1-77 2-77 3-77 4-77 5-77 6-77 7-77 8-77 9-77 10-77 11-77 12-77 1-78 2-78 3-78 4-78 5-78 6-78 7-78 8-78 9-78 10-78 11-78 12-78 1-79 2-79 3-79 4-79 5-79 6-79 7-79 8-79 9-79 10-79 11-79 12-79 1-80 2-80 3-80 4-80 5-80 6-80 7-80 8-80 9-80 10-80 11-80 12-80 1-81 2-81 3-81 4-81 5-81 6-81 7-81 8-81 9-81 10-81 11-81 12-81 1-82 2-82 3-82 4-82 5-82 6-82 7-82 8-82 9-82 10-82 11-82 12-82 1-83 2-83 3-83 4-83 5-83 6-83 7-83 8-83 9-83 10-83 11-83 12-83 1-84 2-84 3-84 4-84 5-84 6-84 7-84 8-84 9-84 10-84 11-84 12-84 1-85 2-85 3-85 4-85 5-85 6-85 7-85 8-85 9-85 10-85 11-85 12-85 1-86 2-86 3-86 4-86 5-86 6-86 7-86 8-86 9-86 10-86 11-86 12-86 1-87 2-87 3-87 4-87 5-87 6-87 7-87 8-87 9-87 10-87 11-87 12-87 1-88 2-88 3-88 4-88 5-88 6-88 7-88 8-88 9-88 10-88 11-88 12-88 1-89 2-89 3-89 4-89 5-89 6-89 7-89 8-89 9-89 10-89 11-89 12-89 1-90 2-90 3-90 4-90 5-90 6-90 7-90 8-90 9-90 10-90 11-90 12-90 1-91 2-91 3-91 4-91 5-91 6-91 7-91 8-91 9-91 10-91 11-91 12-91 1-92 2-92 3-92 4-92 5-92 6-92 7-92 8-92 9-92 10-92 11-92 12-92 1-93 2-93 3-93 4-93 5-93 6-93 7-93 8-93 9-93 10-93 11-93 12-93 1-94 2-94 3-94 4-94 5-94 6-94 7-94 8-94 9-94 10-94 11-94 12-94 1-95 2-95 3-95 4-95 5-95 6-95 7-95 8-95 9-95 10-95 11-95 12-95 1-96 2-96 3-96 4-96 5-96 6-96 7-96 8-96 9-96 10-96 11-96 12-96 1-97 2-97 3-97 4-97 5-97 6-97 7-97 8-97 9-97 10-97 11-97 12-97 1-98 2-98 3-98 4-98 5-98 6-98 7-98 8-98 9-98 10-98 11-98 12-98 1-99 2-99 3-99 4-99 5-99 6-99 7-99 8-99 9-99 10-99 11-99 12-99 1-100 2-100 3-100 4-100 5-100 6-100 7-100 8-100 9-100 10-100 11-100 12-100 1-101 2-101 3-101 4-101 5-101 6-101 7-101 8-101 9-101 10-101 11-101 12-101 1-102 2-102 3-102 4-102 5-102 6-102 7-102 8-102 9-102 10-102 11-102 12-102 1-103 2-103 3-103 4-103 5-103 6-103 7-103 8-103 9-103 10-103 11-103 12-103 1-104 2-104 3-104 4-104 5-104 6-104 7-104 8-104 9-104 10-104 11-104 12-104 1-105 2-105 3-105 4-105 5-105 6-105 7-105 8-105 9-105 10-105 11-105 12-105 1-106 2-106 3-106 4-106 5-106 6-106 7-106 8-106 9-106 10-106 11-106 12-106 1-107 2-107 3-107 4-107 5-107 6-107 7-107 8-107 9-107 10-107 11-107 12-107 1-108 2-108 3-108 4-108 5-108 6-108 7-108 8-108 9-108 10-108 11-108 12-108 1-109 2-109 3-109 4-109 5-109 6-109 7-109 8-109 9-109 10-109 11-109 12-109 1-110 2-110 3-110 4-110 5-110 6-110 7-110 8-110 9-110 10-110 11-110 12-110 1-111 2-111 3-111 4-111 5-111 6-111 7-111 8-111 9-111 10-111 11-111 12-111 1-112 2-112 3-112 4-112 5-112 6-112 7-112 8-112 9-112 10-112 11-112 12-112 1-113 2-113 3-113 4-113 5-113 6-113 7-113 8-113 9-113 10-113 11-113 12-113 1-114 2-114 3-114 4-114 5-114 6-114 7-114 8-114 9-114 10-114 11-114 12-114 1-115 2-115 3-115 4-115 5-115 6-115 7-115 8-115 9-115 10-115 11-115 12-115 1-116 2-116 3-116 4-116 5-116 6-116 7-116 8-116 9-116 10-116 11-116 12-116 1-117 2-117 3-117 4-117 5-117 6-117 7-117 8-117 9-117 10-117 11-117 12-117 1-118 2-118 3-118 4-118 5-118 6-118 7-118 8-118 9-118 10-118 11-118 12-118 1-119 2-119 3-119 4-119 5-119 6-119 7-119 8-119 9-119 10-119 11-119 12-119 1-120 2-120 3-120 4-120 5-120 6-120 7-120 8-120 9-120 10-120 11-120 12-120 1-121 2-121 3-121 4-121 5-121 6-121 7-121 8-121 9-121 10-121 11-121 12-121 1-122 2-122 3-122 4-122 5-122 6-122 7-122 8-122 9-122 10-122 11-122 12-122 1-123 2-123 3-123 4-123 5-123 6-123 7-123 8-123 9-123 10-123 11-123 12-123 1-124 2-124 3-124 4-124 5-124 6-124 7-124 8-124 9-124 10-124 11-124 12-124 1-125 2-125 3-125 4-125 5-125 6-125 7-125 8-125 9-125 10-125 11-125 12-125 1-126 2-126 3-126 4-126 5-126 6-126 7-126 8-126 9-126 10-126 11-126 12-126 1-127 2-127 3-127 4-127 5-127 6-127 7-127 8-127 9-127 10-127 11-127 12-127 1-128 2-128 3-128 4-128 5-128 6-128 7-128 8-128 9-128 10-128 11-128 12-128 1-129 2-129 3-129 4-129 5-129 6-129 7-129 8-129 9-129 10-129 11-129 12-129 1-130 2-130 3-130 4-130 5-130 6-130 7-130 8-130 9-130 10-130 11-130 12-130 1-131 2-131 3-131 4-131 5-131 6-131 7-131 8-131 9-131 10-131 11-131 12-131 1-132 2-132 3-132 4-132 5-132 6-132 7-132 8-132 9-132 10-132 11-132 12-132 1-133 2-133 3-133 4-133 5-133 6-133 7-133 8-133 9-133 10-133 11-133 12-133 1-134 2-134 3-134 4-134 5-134 6-134 7-134 8-134 9-134 10-134 11-134 12-134 1-135 2-135 3-135 4-135 5-135 6-135 7-135 8-135 9-135 10-135 11-135 12-135 1-136 2-136 3-136 4-136 5-136 6-136 7-136 8-136 9-136 10-136 11-136 12-136 1-137 2-137 3-137 4-137 5-137 6-137 7-137 8-137 9-137 10-137 11-137 12-137 1-138 2-138 3-138 4-138 5-138 6-138 7-138 8-138 9-138 10-138 11-138 12-138 1-139 2-139 3-139 4-139 5-139 6-139 7-139 8-139 9-139 10-139 11-139 12-139 1-140 2-140 3-140 4-140 5-140 6-140 7-140 8-140 9-140 10-140 11-140 12-140 1-141 2-141 3-141 4-141 5-141 6-141 7-141 8-141 9-141 10-141 11-141 12-141 1-142 2-142 3-142 4-142 5-142 6-142 7-142 8-142 9-142 10-142 11-142 12-142 1-143 2-143 3-143 4-143 5-143 6-143 7-143 8-143 9-143 10-143 11-143 12-143 1-144 2-144 3-144 4-144 5-144 6-144 7-144 8-144 9-144 10-144 11-144 12-144 1-145 2-145 3-145 4-145 5-145 6-145 7-145 8-145 9-145 10-145 11-145 12-145 1-146 2-146 3-146 4-146 5-146 6-146 7-146 8-146 9-146 10-146 11-146 12-146 1-147 2-147 3-147 4-147 5-147 6-147 7-147 8-147 9-147 10-147 11-147 12-147 1-148 2-148 3-148 4-148 5-148 6-148 7-148 8-148 9-148 10-148 11-148 12-148 1-149 2-149 3-149 4-149 5-149 6-149 7-149 8-149 9-149 10-149 11-149 12-149 1-150 2-150 3-150 4-150 5-150 6-150 7-150 8-150 9-150 10-150 11-150 12-150 1-151 2-151 3-151 4-151 5-151 6-151 7-151 8-151 9-151 10-151 11-151 12-151 1-152 2-152 3-152 4-152 5-152 6-152 7-152 8-152 9-152 10-152 11-152 12-152 1-153 2-153 3-153 4-153 5-153 6-153 7-153 8-153 9-153 10-153 11-153 12-153 1-154 2-154 3-154 4-154 5-154 6-154 7-154 8-154 9-154 10-154 11-154 12-154 1-155 2-155 3-155 4-155 5-155 6-155 7-155 8-155 9-155 10-155 11-155 12-155 1-156 2-156 3-156 4-156 5-156 6-156 7-156 8-156 9-156 10-156 11-156 12-156 1-157 2-157 3-157 4-157 5-157 6-157 7-157 8-157 9-157 10-157 11-157 12-157 1-158 2-158 3-158 4-158 5
---	--	--	--	---	--	--	--	--	---

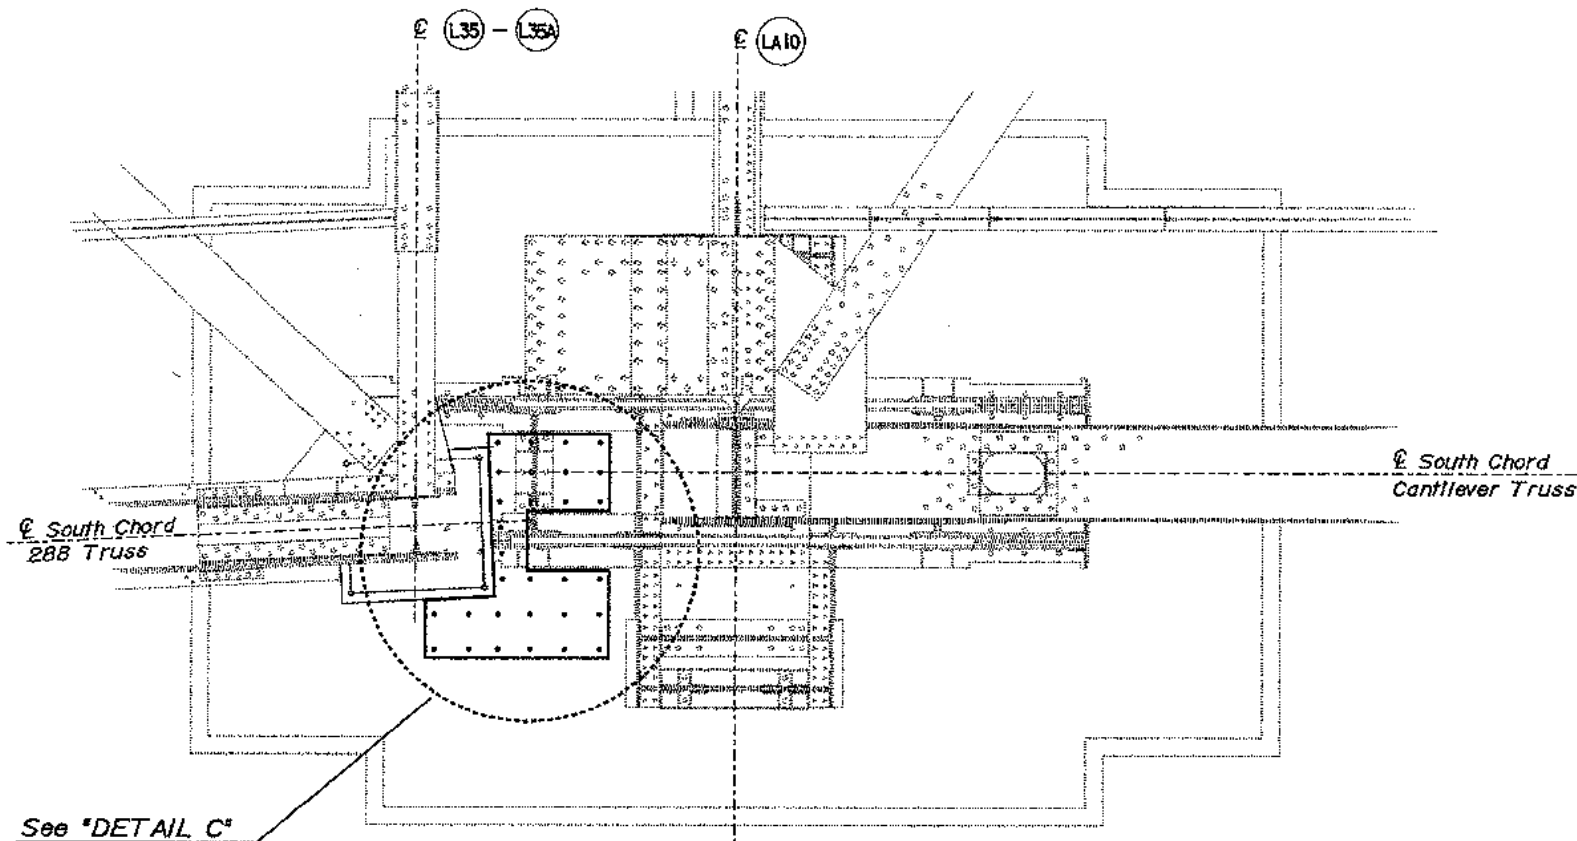


(PIER EI (SOUTH))
PLAN
3/4" = 1'-0"

Notes:

1. Locations of drilled dowel holes for #8 dowels are approximate. Prior to drilling holes in concrete the Contractor shall locate all reinforcing steel and adjust the location of the holes to clear all reinforcing bars. Final hole locations are subject to the approval of the Engineer. The total number of dowels shall remain the same.
2. One side of the concrete bolster shall be placed flush against the existing steel shoe jacket.

NOTE:
THE CONTRACTOR SHALL VERIFY ALL
CONTROLLING FIELD DIMENSIONS
BEFORE ORDERING OR FABRICATING
ANY MATERIAL.

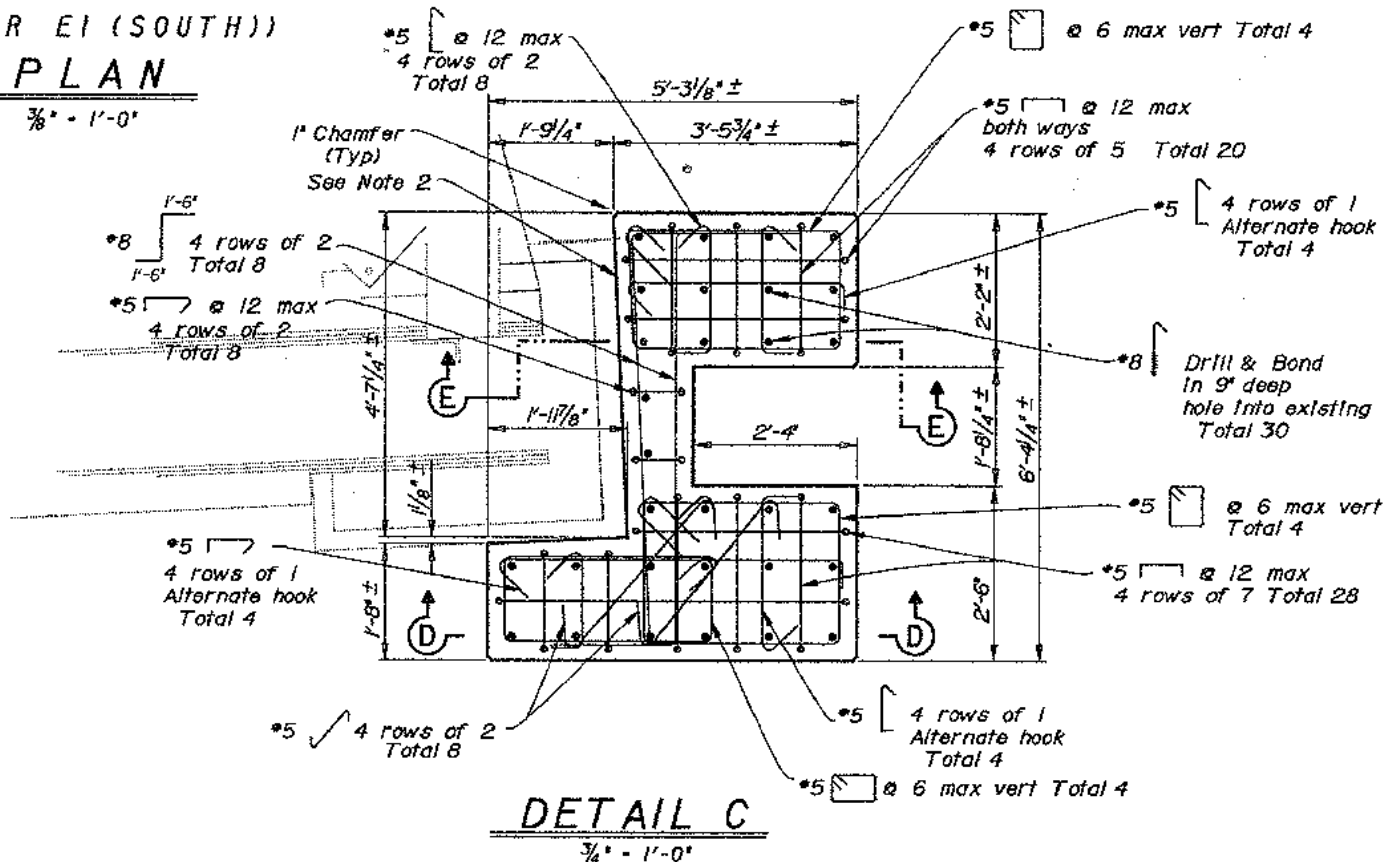

LEGEND



- Indicates Existing Structure
- Indicates New Construction

DIST.	COUNTY	ROUTE	POST MILES TOTAL PROJECT	SHEET NO.	TOTAL SHEETS
04	SF, Alameda	80	7.8/8.9, 0.0/1.1	104	205

REGISTERED ENGINEER - CIVIL
October 26, 1997

12-8-97
PLANS APPROVAL DATE

The State of California or its officers or agents shall not be responsible for the accuracy or completeness of electronic copies of this plan sheet.

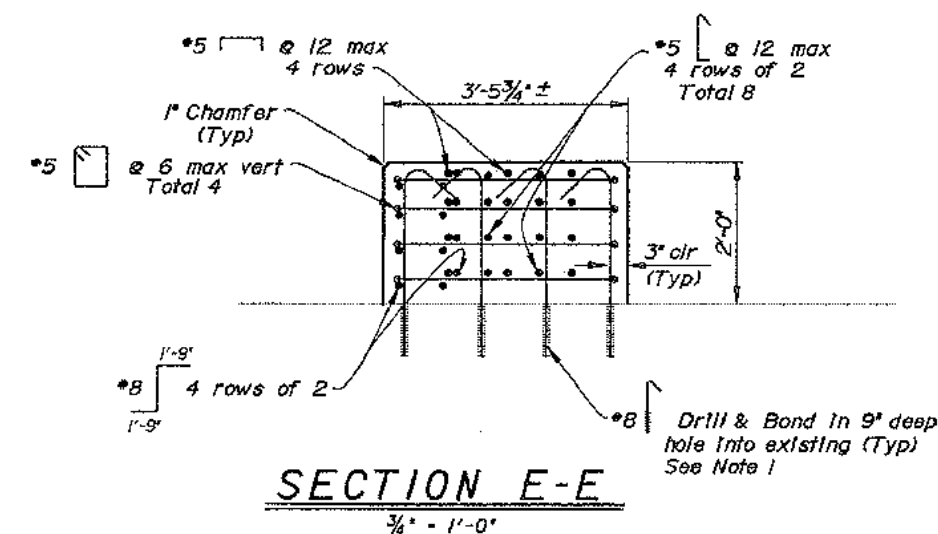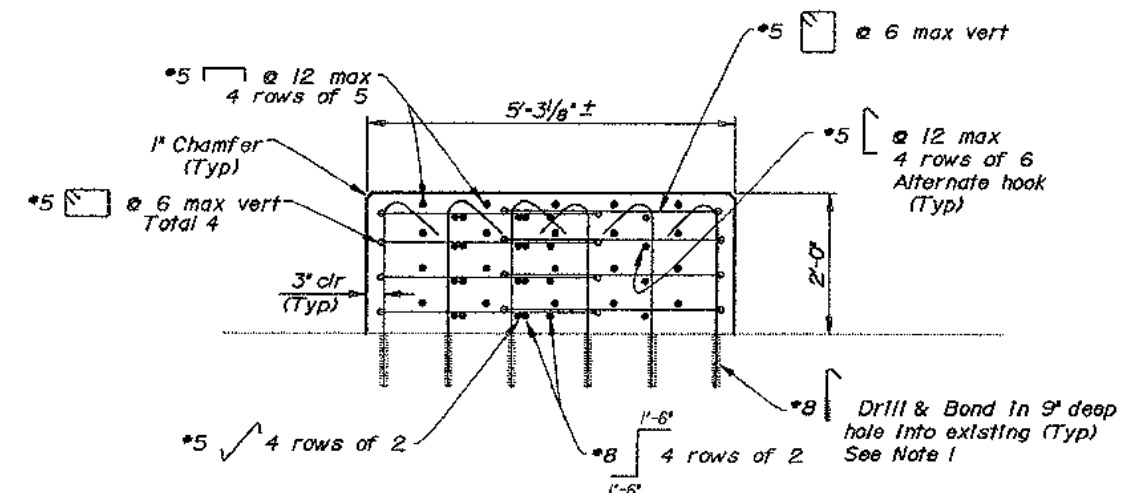

INTERIM SEISMIC RETROFIT PROJECT
EAST BAY 288 TRUSSES YERBA BUENA ISLAND
SAN FRANCISCO-OAKLAND BAY BRIDGE
PIER EI ACHORAGE DETAILS NO. 2

DESIGN	BY Don Lee	10-97	CHECKED E.A. Morris	10-97
DETAILS	BY Ralph Nakagawa	10-97	CHECKED Don Lee	10-97
QUANTITIES	BY E.A. Morris	10-97	CHECKED Don Lee	10-97

STATE OF CALIFORNIA
DIVISION OF STRUCTURES
STRUCTURE DESIGN
TOLL BRIDGE SPECIAL ANALYSIS

BRIDGE NO.	33-0025
POST MILE	1.5